

STATE OF KANSAS
STATE CORPORATION COMMISSION


Give All Information Completely
Make Required Affidavit
Mail or Deliver Report to:
Conservation Division
State Corporation Commission
212 North Market, Insurance Bldg.
Wichita, Kansas

15-185-01132-0000
WELL PLUGGING RECORD

STAFFORD

County. Sec. 33 Twp. 25S Rge. 14W (E) 8W (W)

Location as "NE/CNW/SW" or footage from lines SE SE NW
Lease Owner REX & MORRIS DRILLING CO. & HEARDMORE DRILLING CO.
Lease Name DELKER Well No. 1
Office Address P. O. BOX 334, EL DORADO, KANSAS
Character of Well (completed as Oil, Gas or Dry Hole) DRY HOLE
Date well completed 14 MARCH 19 62
Application for plugging filed 14 MARCH 19 62
Application for plugging approved 16 MARCH 19 62
Plugging commenced 27 MARCH 19 62
Plugging completed 5 APRIL 19 62
Reason for abandonment of well or producing formation DRY HOLE

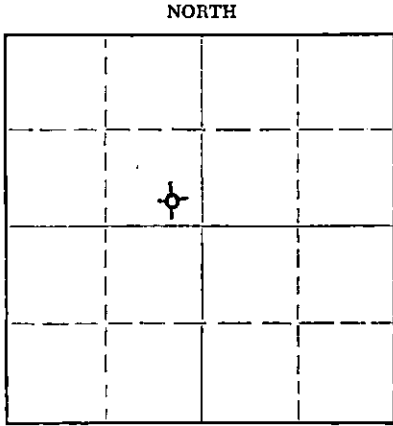

Locate well correctly on above Section Plat

If a producing well is abandoned, date of last production NONE 19
Was permission obtained from the Conservation Division or its agents before plugging was commenced? YES

Name of Conservation Agent who supervised plugging of this well W. L. LAC KAMP
Producing formation NONE Depth to top Bottom Total Depth of Well 4535 Feet
Show depth and thickness of all water, oil and gas formations.

OIL, GAS OR WATER RECORDS

CASING RECORD

FORMATION	CONTENT	FROM	TO	SIZE	PUT IN	PULLED OUT
SURFACE HOLE	WATER	SURFACE	299' RB	8 5/8" OD	293.15'	LEFT IN
OIL STRING	DRY HOLE	SURFACE	4505' RB	5 1/2" OD	4505'	2091'
(SEE ATTACHED LOG)						

Describe in detail the manner in which the well was plugged, indicating where the mud fluid was placed and the method or methods used in introducing it into the hole. If cement or other plugs were used, state the character of same and depth placed, from feet to feet for each plug set.

CEMENT WAS LEFT IN HOLE TO 4437', ALUMINUM G O PLUG AT 3975' WITH 8' OF ROCK, FILLED HOLE TO 3930' WITH SAND & DUMPED 4 SACKS CEMENT, PUMPED HOLE FULL OF DRILLING MUD TO 270', PUT IN 10' ROCK BRIDGE AND DUMPED 3 SACKS CEMENT, BAILED HOLE DOWN, TESTED DRY, DUMPED IN 17 SACKS CEMENT, FILLED WITH DRILLING MUD TO 35', PUT IN 10' ROCK BRIDGE AND DUMPED 10 SACKS CEMENT.

RECEIVED
STATE CORPORATION COMMISSION

APR 21 1962

CONSERVATION DIVISION
Wichita, Kansas

4-24-62

(If additional description is necessary, use BACK of this sheet)
Name of Plugging Contractor RALPH COMSTOCK PIPE PULLING, INC.
Address 411 SOUTH BUCKEYE, STAFFORD, KANSAS

STATE OF KANSAS, COUNTY OF BUTLER, ss.
A. H. FISHER

(employee of owner) or (owner or operator) of the above-described well, being first duly sworn on oath, says: That I have knowledge of the facts, statements, and matters herein contained and the log of the above-described well as filed and that the same are true and correct. So help me God.

(Signature) A. H. Fisher

P. O. BOX 334, EL DORADO, KANSAS
(Address)

SUBSCRIBED AND SWORN to before me this 23RD day of APRIL, 19 62

My commission expires

8 AUGUST 1962

Elizabeth Deschner
ELIZABETH DESCHNER Notary Public.



DECKER # 1

Rex & Morris Drilling Company and
Beardmore Drilling Company

Total Depth: 2535
Contractor: Rex & Morris
Commenced: 2-10-62
Completed: 3-14-62
Initial Prod.: D. & A.

Location: SE SE NW
Section 33-25S-14W
Stafford County, Kansas

Casing Record:
3 5/8 @ 399' w/240 sacks
5 1/2 @ 4503' w/97 sacks

FORMATION	DEPTH
Surface Hole	299
Shale	910
Anhydrite	920
Shale	1405
Shale and Lime	1960
Lime and Shale	3635
Shale and Lime	3777
Lime	4255
Shale	4274
Chert and Lime	4315
Lime R.T.D.	4535

RECEIVED
STATE CORPORATION COMMISSION
APR 10 1962
CONSERVATION DIVISION
Wichita, Kansas
4-24-62

Ran Schlumberger GR-LL-MLL.
R.U.S.T. Perf. 4 holes - 4010' Re-cemented w/100 sacks.
Drill cement and C.O. to 4375'. Ran G.R. 4375'.
Perf. 4278-88, 6 per foot. Acid 1000 gal.
Swab 8 hrs. 120 bbls. fluid, showing heavy oil.
F.U. 2200', 13 hrs. (58.71 BW, 3.54 BO)
Swab 8 hrs. (55.37 BW, 3.34 bbls. heavy oil.)
Set plug @ 3975'. Tested dry.
Perf. 3942-49', 6 per foot. Test 13 hrs. - 10 gal. water,
3 gal. oil. Acid 1000 gal. Swab 288 BW and 35 BO. (25% water),
8 hours.
F.U. 2600', 16 hrs. Swab 256 BW, 13 BO, 8 hrs.
1200' off bottom. Plug and abandon.

I hereby certify the foregoing statements are true and correct to the best of my knowledge and belief.

REX & MORRIS DRILLING COMPANY
By Paul D. Koontz
Paul D. Koontz, Geologist

STATE OF KANSAS
COUNTY OF BUTLER, SS.

Subscribed and sworn to before me, a Notary Public, this 22nd day of March, 1962.

Elizabeth Deschner
Elizabeth Deschner, Notary Public

My commission expires: August 8, 1962.