

15-155-02710-0000

STATE OF KANSAS
STATE CORPORATION COMMISSION

WELL PLUGGING RECORD


Give All Information Completely
Notice Required Affidavit
Mail or Deliver Report to:
Conservation Division
State Corporation Commission
800 Bittling Building
Wichita, Kansas

OR

FORMATION PLUGGING RECORD

Strike out upper line
when reporting plug-
ging of formations.

NORTH

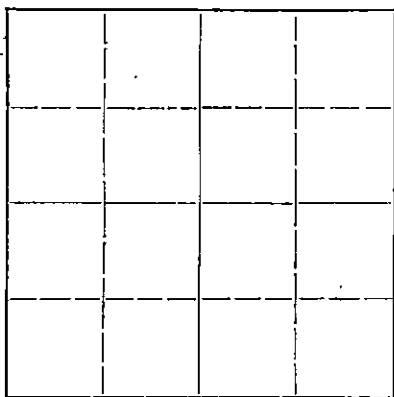

Locate well correctly on above
Section Flat

..... Reno County.. Sec. 34 Twp 25S Rge. (E) 4 (W)
Location as "NE 1/4 NW 1/4 SW 1/4" or footage from lines 990 fr EL & 330 fr SL
Lease Owner..... Phillips Petroleum Company
Lease Name..... Manning Well No. 2
Office Address..... Bartlesville, Oklahoma.
Character of Well (completed as Oil, Gas or Dry Hole)..... Oil
Date well completed..... 11-20-43 19.....
Application for plugging filed..... October 8, 1948 19.....
Application for plugging approved..... October 8, 1948 19.....
Plugging commenced..... October 9, 1948 19.....
Plugging completed..... October 13, 1948 19.....
Reason for abandonment of well or producing formation..... Unprofitable to operate.

If a producing well is abandoned, date of last production..... 7-14-48 19.....
Was permission obtained from the Conservation Division or its agents before plugging was com-
menced?..... Yes

Name of Conservation Agent who supervised plugging of this well..... Ruel Durkee
Producing formation..... Viola Lime Depth to top..... 4111 1/2 Bottom..... Total Depth of Well..... 4116 1/2 Feet
Show depth and thickness of all water, oil and gas formations.

OIL, GAS OR WATER RECORDS

CASING RECORD

Formation	Content	From	To	Size	Put In	Pulled Out
Mississippi Chat		3650'		5 1/2"	4135.88	3238' 11"
Viola Lime	Oil	4111 1/2'		8 5/8"	299' 8"	

Describe in detail the manner in which the well was plugged, indicating where the mud fluid was placed and the method or methods used in introducing it into the hold. If cement or other plugs were used, state the character of same and depth placed, from..... feet to..... feet for each plug set.

Rocked hole from 4116 1/2 to 4111'. Run 10 sacks cement.
Pulled casing and mudded hole to 306'. Run 15 sacks cement.
Mudded hole to 20'. Run 5 sacks of cement. Well Completed.

(If additional description is necessary, use BACK of this sheet)

Correspondence regarding this well should be addressed to..... N. C. Mortimer
Address..... Box 779, Great Bend, Kansas. 11-248

STATE OF..... Kansas..... COUNTY OF..... Barton....., ss.
..... A. L. Rhodes..... (employee of owner) or (owner or operator) of the above-described well,
being first duly sworn on oath, says: That I have knowledge of the facts, statements, and matters herein contained and the log of the above-
described well as filed and that the same are true and correct. So help me God.


(Signature)..... A. L. Rhodes

Box 779, Great Bend, Kansas
(Address)

SUBSCRIBED AND SWORN to before me this..... 10th..... day of..... November....., 19 48

..... Notary Public.

My commission expires..... March 27, 1950

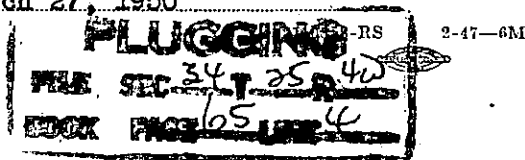

Formation Record

Lease Manning

Well No. 2

FROM	TO	Formation	REMARKS
0	150	Surface Clay & Sand	
150	425	Shale & Shells	
425	740	Shale	
740	880	Anhydrite	
880	1215	Lime & Shale	
1215	1367	Shale	
1367	1595	Lime & Shale	
1595	1718	Broken Lime	
1718	1965	Lime & Shale	
1965	2754	Lime	
2754	2815	Lime & Shale	
2815	3604	Lime	
3604	3625	Lime & Shale	
3625	3657	Shale	
3657	3925	Lime	
3925	3968	Lime & Shale	
3968	3982	Shale	
3982	4005	Lime & Shale	
4005	4111 $\frac{1}{2}$	Shale	
4111 $\frac{1}{2}$	4116 $\frac{1}{2}$	Lime	
T.D.	4116 $\frac{1}{2}$		

PLUGGING
 FILE SEC-24T-25R-42
 BOOK PAGE 65 LINE 4

RECEIVED
 NOV 19 1948
 STATE COMMISSION
 CONSERVATION
 KANSAS
 11-12-48