15-155-02712-0000

STATE OF KANSAS
STATE CORPORATION COMMISSION

Give All Information Completely
Make Required Affidavit
Mail or Deliver Report to:
Conservation Division
State Corporation Commission
800 Bitting Building
Wichita, Kansas

WELL PLUGGING RECORD

NORTH

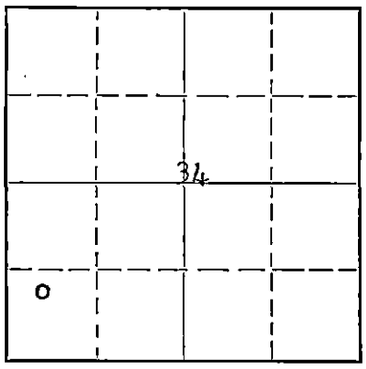

Locate well correctly on above Section Plat

Reno County. Sec. 34 Twp. 25 Rge. 4 (E) W (W) X

Location as "NE/CNW¼SW¼" or footage from lines NW SW SW

Lease Owner The El Dorado Refining Co.

Lease Name Newby Well No. 2

Office Address Box 551, El Dorado, Kansas

Character of Well (completed as Oil, Gas or Dry Hole) Oil

Date well completed 5-24 19 49

Application for plugging filed 12-14- 19 51

Application for plugging approved 12-17 19 51

Plugging commenced 1-11 19 52

Plugging completed 1-17 19 52

Reason for abandonment of well or producing formation
Productivity exhausted

If a producing well is abandoned, date of last production 11-1 19 51

Was permission obtained from the Conservation Division or its agents before plugging was commenced? Yes.

Name of Conservation Agent who supervised plugging of this well Mr. Durkee

Producing formation Arb. Viola Depth to top 4,089 Bottom Total Depth of Well 4092½ Feet

Show depth and thickness of all water, oil and gas formations.

OIL, GAS OR WATER RECORDS

CASING RECORD

Formation	Content	From	To	Size	Put In	Pulled Out
				8-5/8	362'	000'
				5-1/2	4089'	3407'6"

Describe in detail the manner in which the well was plugged, indicating where the mud fluid was placed and the method or methods used in introducing it into the hole. If cement or other plugs were used, state the character of same and depth placed, from ..... feet to ..... feet for each plug set.

Filled hole with sand from 4092' to 4080'
Run 6 sacks of cement at 4080' - Mudded to 355'
Set bridge and rock to 345' - Run 15 sacks of
cement at 345' - Mudded to 15' - Run 5 sacks of
cement to cap.

(If additional description is necessary, use BACK of this sheet)

Correspondence regarding this well should be addressed to The El Dorado Refining Company

Address Box 209 - Russell, Kansas

STATE OF KANSAS, COUNTY OF RUSSELL, ss.

Levi B. Sherman (employee of owner) or (owner or operator) of the above-described well, being first duly sworn on oath, says: That I have knowledge of the facts, statements, and matters herein contained and the log of the above-described well as filed and that the same are true and correct. So help me God.

(Signature) Levi B. Sherman

Box 209 - Russell, Kansas
(Address)

SUBSCRIBED AND SWORN TO before me this 30 day of January, 1952.

Herbert B. Smith
Notary Public.

My commission expires 9-13-55

23-5091-s 8-50—10M

PLUGGING
FILE SEC 34 T 25 R 4W
BOOK PAGE 131 LINE 42

JAN 31 1952
Wichita, Kansas

1-31-52

15-155-02712-0000

THE EL DORADO REFINING COMPANY

EL DORADO, KANSAS

WELL LOG *NEWBY # 2.

Location NW SW SW of Section 34-25S-4W, Reno County, Kansas

Commenced - 4-1-49
Completed - 4-19-49 (w/r)

Owner - The El Dorado Refining Company
Contractor- Sterling Drilling Company

Total Depth - 4092½(w/r)

	LOG
0- 100	Surface Clay and Shale
100- 440	Shale and Shells
440- 450	Anhydrite
450- 675	Shale, Shells and Salt
675-1230	Lime and Shale
1230-1630	Lime
1630-1685	Shale and Shells
1685-1900	Shale
1900-2330	Shale and Lime
2330-2420	Lime
2420-2515	Lime and Shale
2515-2655	Lime
2655-2765	Lime and Shale
2765-2860	Shale
2860-2945	Shale and Lime
2945-3465	Lime
3465-3615	Lime and Shale
3615-3645	Sand and Shale
3645-3695	Chat
3695-3775	Chat -- Chert
3775-3955	Lime
3955-4091	Shale
4091-4092½	Viola Lime
4092½	TOTAL DEPTH

CASING RECORD

362' 8-5/8" Surface Pipe
Cemented with 275 Sacks Cement.
4113' 5½" O. D. Casing
Set at 4089'.
Cemented with 100 Sacks Cement

PRODUCTION

Producer. (Oil Well).

JAN 22 1952
Conservation Division
Wichita, Kansas

1-22-52

PLUGGING
FILE SEC. 34 T. 25 R. 4W
BOOK PAGE 131 LINE 4X

THE EL DORADO REFINING COMPANY

EL DORADO, KANSAS

WELL LOG *NEWBY # 2.

Location NW SW SW of Section 34-25S-4W, Reno County, Kansas

Commenced - 4-1-49
Completed - 4-19-49 (w/r)

Owner - The El Dorado Refining Company
Contractor- Sterling Drilling Company

Total Depth - 4092½(w/r)

	LOG
0- 100	Surface Clay and Shale
100- 440	Shale and Shells
440- 450	Anhydrite
450- 675	Shale, Shells and Salt
675-1230	Lime and Shale
1230-1630	Lime
1630-1685	Shale and Shells
1685-1900	Shale
1900-2330	Shale and Lime
2330-2420	Lime
2420-2515	Lime and Shale
2515-2655	Lime
2655-2765	Lime and Shale
2765-2860	Shale
2860-2945	Shale and Lime
2945-3465	Lime
3465-3615	Lime and Shale
3615-3645	Sand and Shale
3645-3695	Chat
3695-3775	Chat -- Chert
3775-3955	Lime
3955-4091	Shale
4091-4092½	Viola Lime
4092½	TOTAL DEPTH

CASING RECORD

362' 8-5/8" Surface Pipe
Cemented with 275 Sacks Cement.
4113' 5½" O. D. Casing
Set at 4089'.
Cemented with 100 Sacks Cement

PRODUCTION

Producer. (Oil Well).

DEC 7 1951

FILE 34-25-4W
BOOK