


STATE OF KANSAS  
STATE CORPORATION COMMISSION

Form CP-4

WELL PLUGGING RECORD

Give All Information Completely  
Make Required Affidavit  
Mail or Deliver Report to:  
Conservation Division  
State Corporation Commission  
212 No. Market  
Wichita, Kansas

NORTH

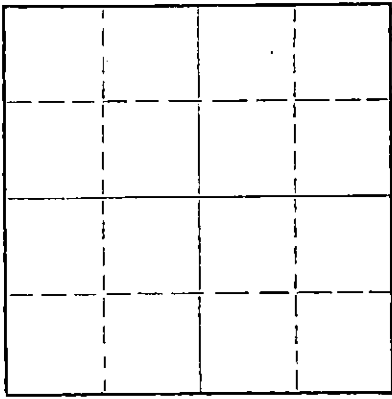

Locate well correctly on above  
Section Plat

Reno County, Sec. 5 Twp. 25S Rge. 5 (X) 5 (W)  
Location as "NE/CNW/SW" or footage from lines 5/2 NE SW  
Lease Owner A. Scott Ritchie  
Lease Name Haines Well No. 1  
Office Address 413 Union Center, Wichita, Kansas 67202  
Character of Well (completed as Oil, Gas or Dry Hole) Dry Hole  
Date well completed December 6, 19 67  
Application for plugging filed December 6, 19 67  
Application for plugging approved December 6, 19 67  
Plugging commenced December 6, 19 67  
Plugging completed December 6, 19 67  
Reason for abandonment of well or producing formation \_\_\_\_\_

If a producing well is abandoned, date of last production \_\_\_\_\_ 19\_\_\_\_  
Was permission obtained from the Conservation Division or its agents before plugging was commenced? Yes

Name of Conservation Agent who supervised plugging of this well Herman E. Justus, Nickerson, Kansas  
Producing formation \_\_\_\_\_ Depth to top \_\_\_\_\_ Bottom \_\_\_\_\_ Total Depth of Well 3535 Feet  
Show depth and thickness of all water, oil and gas formations.

OIL, GAS OR WATER RECORDS

CASING RECORD

FORMATION	CONTENT	FROM	TO	SIZE	PUT IN	PULLED OUT
				10"	245'	None

Describe in detail the manner in which the well was plugged, indicating where the mud fluid was placed and the method or methods used in introducing it into the hole. If cement or other plugs were used, state the character of same and depth placed, from \_\_\_\_\_ feet to \_\_\_\_\_ feet for each plug set.

Mudded up with heavy mud to 240 feet. Followed by wooden plug and 1/2 sack hulls. Placed 30 sacks cement onto hulls. Mudded up with heavy mud to 40 feet followed by wooden plug, 1/2 sack hulls and 15 sacks cement to base of well cellar. Plugged rat hole with 2 sacks cement.

REC'D  
STATE CORPORATION COMMISSION  
DEC 12 1967  
12-12-67  
CONSERVATION DIVISION  
WICHITA, KANSAS

(If additional description is necessary, use BACK of this sheet)

Name of Plugging Contractor Graves Drilling Co., Inc.  
Address 505 Union Center, Wichita, Kansas 67202

STATE OF KANSAS, COUNTY OF SEDGWICK, ss.  
John C. Graves (employee of owner) or (owner or operator) of the above-described well, being first duly sworn on oath, says: That I have knowledge of the facts, statements, and matters herein contained and the log of the above-described well as filed and that the same are true and correct. So help me God.

(Signature) John C. Graves  
505 Union Center, Wichita, Kansas 67202  
(Address)

SUBSCRIBED AND SWORN TO before me this 11th day of December, 19 67

My commission expires May 9, 1971

Betty Brandt  
Betty Brandt Notary Public.

ROTARY DRILLERS' LOG

OPERATOR: A. Scott Ritchie  
413 Union Center  
Wichita, Kansas

DRILLING COMMENCED: November 27, 1967

CONTRACTOR: Graves Drilling Co., Inc.  
505 Union Center  
Wichita, Kansas

DRILLING COMPLETED: December 6, 1967

CASING RECORD: 13 Jts. 245' - 10"  
cemented with 175 sacks

LOCATION: Haines No. 1  
*SW* NE SW  
Section 5-25S-5W  
Reno County, Kansas

-----

0 - 152	Sod, clay, sand & shale
152 - 325	Shale & shells
325 - 699	Shale, shells & sand
699 - 1236	Lime & shale
1236 - 1610	Broken lime & shale
1610 - 2193	Shale & lime
2193 - 2559	Lime & shale
2559 - 2772	Sandy shale
2772 - 3209	Lime
3209 - 3376	Lime & shale
3376 - 3471	Shale & lime
3471 - 3477	Lime & chert
3477 - 3485	Chert
3485 - 3503	Chert & lime
3503 - 3535	Chert
3535	Rotary Total Depth

RECEIVED  
STATE CORPORATION COMMISSION  
DEC 12 1967  
12-12-67  
CONSERVATION DIVISION  
Topeka, Kansas

I hereby certify the foregoing statements to be true and correct to the best of my knowledge.

GRAVES DRILLING CO., INC.

By *John Graves*  
President

STATE OF KANSAS )  
                  ) SS:  
SEDGWICK COUNTY )

Subscribed and sworn to before me, a Notary Public, this 11th of December, 1967.

*Betty Brandt*  
Betty Brandt Notary Public

My commission expires:  
May 9, 1971