

STATE OF KANSAS  
STATE CORPORATION COMMISSION


WELL PLUGGING RECORD

Give All Information Completely  
Make Required Affidavit  
Mail or Deliver Report to:  
Conservation Division  
State Corporation Commission  
800 Bittig Building  
Wichita, Kansas

Reno County. Sec. 21 Twp. 25 Rge. 4 (X) (W)

Location as "NE/CNW/SW" or footage from lines NW NW NW  
Lease Owner Aylward Drilling Company & Aurora Gasoline Co.  
Lease Name Tom Well No. 1  
Office Address 813 1st Natl. Bank Bldg. - Wichita, Kansas  
Character of Well (completed as Oil, Gas or Dry Hole) Dry Hole  
Date well completed October 9 19 55  
Application for plugging filed October 9 19 55  
Application for plugging approved October 10 19 55  
Plugging commenced October 9 19 55  
Plugging completed October 9 19 55  
Reason for abandonment of well or producing formation

NORTH

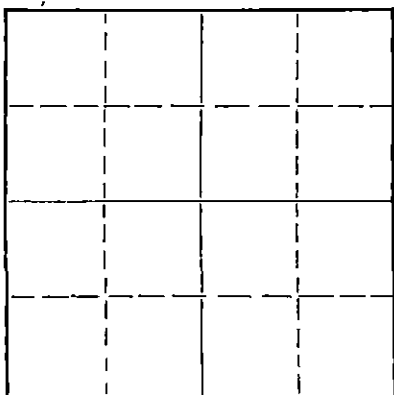

Locate well correctly on above  
Section Plat

If a producing well is abandoned, date of last production 19  
Was permission obtained from the Conservation Division or its agents before plugging was com-  
menced? Yes

Name of Conservation Agent who supervised plugging of this well Ruel Durkee  
Producing formation Depth to top Bottom Total Depth of Well 4130 Feet  
Show depth and thickness of all water, oil and gas formations.

OIL, GAS OR WATER RECORDS

CASING RECORD

FORMATION	CONTENT	FROM	TO	SIZE	PUT IN	PULLED OUT
				8 5/8"	138'	None

Describe in detail the manner in which the well was plugged, indicating where the mud fluid was placed and the method or methods used in introducing it into the hole. If cement or other plugs were used, state the character of same and depth placed, from feet to feet for each plug set.

Gunned pits, filled hole with heavy mud from 4130' (circulated mud at 2230') to 129'; bridge at 129'- 15 sacks on top of bridge cemented through drill pipe from 129' to 84'; heavy mud from 84' to 20'- 5 sacks cement from 20' to bottom of cellar (Halliburton plug and 1/2 sack hulls was set at 20' before 5 sacks of cement was put in).

(If additional description is necessary, use BACK of this sheet)

Name of Plugging Contractor Aylward Drilling Company  
Address 813 1st Natl. Bank Bldg. \* Wichita, Kansas


STATE OF Kansas, COUNTY OF Sedgwick, ss.  
Paul W. Hesse (employee of owner) or (superintendent) of the above-described well, being first duly sworn on oath, says: That I have knowledge of the facts, statements, and matters herein contained and the log of the above-described well as filed and that the same are true and correct. So help me God.

(Signature) Paul W. Hesse  
813 1st Natl. Bank Bldg. Wichita, Kansas (Address)

SUBSCRIBED AND SWORN TO before me this 12th day of October, 19 55

My commission expires December 11, 1957

Duane Jessup  
Duane Jessup Notary Public.

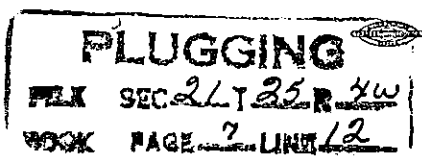

10-14-55

TONN #1

Casing Record:

8-5/8" 138' w/ 100 Sacks Pozmix

Company: Aylward Drilling Company & Aurora Gasoline Company

Contractor: Aylward Drilling Company

Commenced: September 24, 1955

Completed: October 9, 1955

Location: NW NW NW

Sec. 21-25S-4W

Reno County, Kansas

Elevation: 1506 D.F.

	<u>From</u>	<u>To</u>	<u>Remarks</u>	
Red Rock	0	73	<u>GEOLOGICAL TOPS</u>	
Red Rock & Gravel	73	138		
Shale & Shells	138	599	Heebner	2552
Shale & Shells	599	620	Douglas Shale	2613
Shale & Lime	620	920	Lansing K.C.	2778
Lime	920	1395	Conglomerate	3539
Lime & Shale	1395	1750	Mississippi Limestone	3554
Lime & Shale	1750	1975	Maquoketa	3938
Lime & Shale	1975	2215	Viola	3999
Shale	2215	2530	Arbuckle	4099
Lime & Shale	2530	2973	RTD	4130
Lime	2973	3022		
Lime	3022	3155		
Lime & Shale Streaks	3155	3215		
Lime & Shale	3215	3235		
Lime	3235	3313		
Sandy Lime & Shale	3313	3422		
Shale	3422	3525		
Lime	3525	3540		
Conglomerate	3540	3560		
Cherty Lime	3560	3618		
Cherty Lime	3618	3652		
Chert	3652	3699		
Lime & Chert Streaks	3699	3740		
Lime Shale & Chert	3740	3763		
Lime & Shale	3763	3788		
Lime & Shale	3788	3998		
Lime	3998	4016		
Lime	4016	4019		
Shale & Lime	4019	4076		
Lime & Shale	4076	4099		
Lime	4099	4130	R.T.D.	

I certify that this is a true and correct copy of the above log to the best of my knowledge.

Paul W. Hesse  
Paul W. Hesse

Subscribed and sworn to before me this 12<sup>TH</sup> day of OCTOBER, 1955.

Duane Jessup  
Duane Jessup  
Notary Public

My Commission Expires: December 11, 1957.

**PLUGGING**  
PLX SEC 21-25 R 4W  
BOOK PAGE 7 LINE 12

10-14-55