


STATE OF KANSAS
STATE CORPORATION COMMISSION

Form CP-4

Give All Information Completely
Make Required Affidavit
Mail or Deliver Report to:
Conservation Division
State Corporation Commission
P. O. Box 17027
Wichita, Kansas 67217
NORTH

WELL PLUGGING RECORD

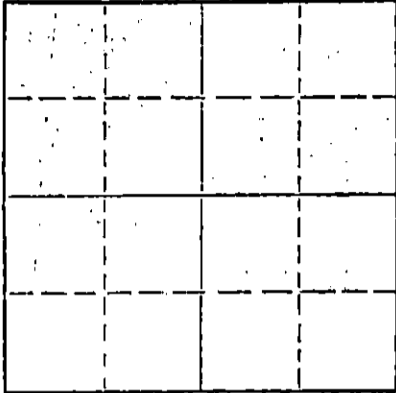

Locate well correctly on above
Section Plot

Reno County, Sec. 26 Twp. 25S Rge. 4W (E) (W) X
Location as "NE/CNW/SE/SW" or footage from lines SE SE NE
Lease Owner Acme Oil Corporation
Lease Name Callias Well No. 1
Office Address 6235 West Kellogg, Wichita, Kansas 67209
Character of Well (completed as Oil, Gas or Dry Hole) D&A
Date well completed November 17 1972
Application for plugging filed November 17 1972
Application for plugging approved November 17 1972
Plugging commenced November 17 1972
Plugging completed November 17 1972
Reason for abandonment of well or producing formation D&A

If a producing well is abandoned, date of last production 19
Was permission obtained from the Conservation Division or its agents before plugging was commenced? Yes

Name of Conservation Agent who supervised plugging of this well Gilbert Toman (Hugh Scott)
Producing formation Depth to top Bottom Total Depth of Well 4081 Feet
Show depth and thickness of all water, oil and gas formations.

OIL, GAS OR WATER RECORDS

CASING RECORD

FORMATION	CONTENT	FROM	TO	SIZE	PUT IN	PULLED OUT
				8-5/8"	220'	-0-

Describe in detail the manner in which the well was plugged, indicating where the mud fluid was placed and the method or methods used in introducing it into the hole. If cement or other plugs were used, state the character of same and depth placed, from feet to feet for each plug set.


Plugged hole w/mud to 240', 1/2 sx hulls, plug @ 240' w/25 sx cement, mud to 40', plug @ 40' w/10 sx cement, 2 sx rathole.

RECEIVED
STATE CORPORATION COMMISSION
NOV 22 1972
CONSERVATION DIVISION
Wichita, Kansas
11-22-72

(If additional description is necessary, use BACK of this sheet)
Name of Plugging Contractor Red Tiger Drilling Company
Address 1720 Wichita Plaza, Wichita, Kansas 67202

STATE OF Kansas COUNTY OF Sedgwick ss.
Virginia K. Albert (employee of owner) or (owner or operator) of the above-described well, being first duly sworn on oath, says: That I have knowledge of the facts, statements, and matters herein contained and the log of the above described well as filed and that the same are true and correct. So help me God.

(Signature) Virginia K. Albert
1720 Wichita Plaza, Wichita, Ks. 67202
(Address)

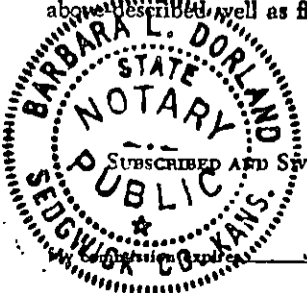

SUBSCRIBED AND SWORN TO before me this 20th day of November, 1972.
Barbara L. Dorland
Notary Public.

DRILLERS LOG

No. 1 Callias

CASING RECORD:	COMPANY:	Acme Oil Corporation	DESCRIPTION:
8-5/8" @ 220' w/160 sx cement	CONTRACTOR:	Red Tiger Drilling Co.	SE SE NE 26-25S-4W Reno County, Kansas
TOTAL DEPTH: 4081'	COMMENCED:	November 4, 1972	ELEVATION:
	COMPLETED:	November 17, 1972	

<u>FORMATION</u>	<u>FROM</u>	<u>TO</u>	<u>REMARKS</u>
Sandy Soil & Clay	0	72	
Redbed & Shale	72	222	
Shale & Shells	222	610	
Shale - Salt	610	675	
Lime & Shale	675	2380	
Lime	2380	2710	
Shale & Lime	2710	2764	
B. Lime	2764	2770	
Shale & Lime	2770	2815	
Lansing Kansas City	2815	2826	
Lime	2826	3225	
Lime & Shale	3225	3315	
Lime & Shale Streaks	3315	3390	
Lime	3390	3444	
Shale & Lime	3444	3624	
Mississippi	3624	3970	
Kinderhook	3970	4052	
Shale & Sand	4052	4081	

RECEIVED
STATE CORPORATION COMMISSION
NOV 22 1972
CONSERVATION DIVISION
Wichita, Kansas
11-22-72

I certify that this is a true and correct copy of the above log to the best of my knowledge.

RED TIGER DRILLING COMPANY

Virginia K. Albert
Virginia K. Albert

Subscribed and sworn to before me this 20th day of November, 1972.

Barbara L. Dorland
Notary Public

My Commission Expires:
July 25, 1976.

