

CARD MUST BE TYPED

State of Kansas

CARD MUST BE SIGNED

NOTICE OF INTENTION TO DRILL

(see rules on reverse side)

Starting Date 2 .. 20 .. 86
month day year

API Number 15— 155-21095-0000

OPERATOR: License # 4752
 Name Source Petroleum
 Address Ste. 910 Century Plaza Bldg.
 City/State/Zip Wichita, KS 67202
 Contact Person Phil Hargis
 Phone (316) 262-7397

..... East
 C. W/2 NW Sec. 28.. Twp. 25... S, Rg. 6..... X West
 3960 Ft. from South Line of Section
 4620 Ft. from East Line of Section

(Note: Locate well on Section Plat on reverse side)

CONTRACTOR: License #
 Name Unknown
 City/State

Nearest lease or unit boundary line 330 feet
 County Reno
 Lease Name Goering Well # 1
 Ground surface elevation 1540 feet MSL
 Domestic well within 330 feet:yes X no
 Municipal well within one mile:yes X no
 Depth to bottom of fresh water 50.6'
 Depth to bottom of usable water 150
 Surface pipe by Alternate: 1 X 2
 Surface pipe planned to be set 200
 Conductor pipe required None
 Projected Total Depth 4050 feet
 Formation Simpson

Well Drilled For: Well Class: Type Equipment:
 X Oil SWD Infield X Mud Rotary
 Gas Inj X Pool Ext Air Rotary
 OWWO Expl Wildcat Cable

If OWWO: old well info as follows:

Operator
 Well Name
 Comp Date Old Total Depth

I certify that well will comply with K.S.A. 55-101, et seq., plus eventually plugging hole to KCC specifications.

Date 1-28-87 Signature of Operator or Agent Phil Hargis Title Geologist/Partner

For KCC Use:


Conductor Pipe Required feet; Minimum Surface Pipe Required 150 feet per Alt. 1 4
 This Authorization Expires 7-29-87 Approved By 1-29-87

Must be filed with the K.C.C. five (5) days prior to commencing well
This card void if drilling not started within six (6) months of date received by K.C.C.

Important procedures to follow:

1. Notify District office before setting surface casing.
2. Set surface casing by circulating cement to the top.
3. File completion forms ACO-1 with K.C.C. within 90 days of well completion, following instructions on ACO-1, side 1, and including copies of wireline logs.
4. Notify District office 48 hours prior to old well workover or re-entry.
5. Prior to filing Intent, prepare a proposed plugging plan in case well is D & A, then obtain approval of plan when calling district office prior to setting surface pipe.
6. Submit plugging report (CP-4) to K.C.C. after plugging is completed.
7. Obtain an approved injection docket number before disposing of salt water.
8. Notify K.C.C. within 10 days when injection commences or terminates.
9. If an alternate 2 completion, cement in the production pipe from below any usable water to surface within 120 days of spud date.

A Regular Section of Land
1 Mile = 5,280 Ft.

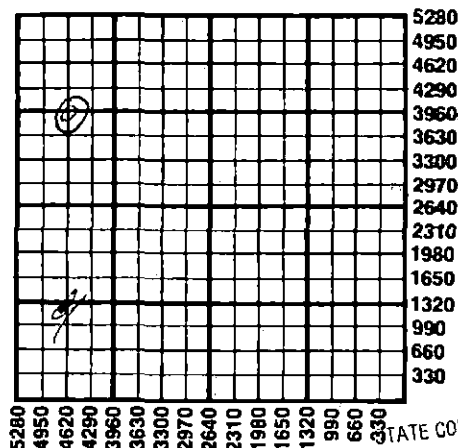

STATE CORPORATION COMMISSION
JAN 29 1987
CONSERVATION DIVISION
Wichita, Kansas

1-29-87

State Corporation Commission of Kansas
Conservation Division
200 Colorado Derby Building
Wichita, Kansas 67202
(316) 263-3238