


STATE OF KANSAS
STATE CORPORATION COMMISSION

Form CP-4

Give All Information Completely
Make Required Affidavit
Mail or Deliver Report to:
Conservation Division
State Corporation Commission

WELL PLUGGING RECORD

P. O. Box 17027
Wichita, Kansas 67217
NORTH

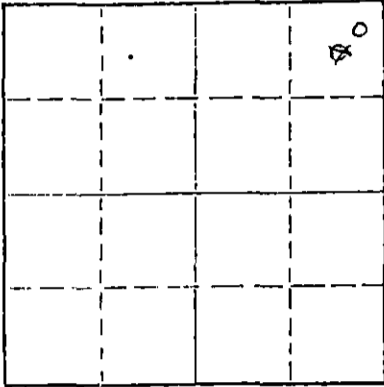

Locate well correctly on above
Section Plat

Edwards County, Sec. 11 Twp. 24s Rge. (E)-16-(W)
Location as "NE/CNWxSWx" or footage from lines NE NE NE
Lease Owner Alpine drilling co. Inc.
Lease Name Belt Well No. 2
Office Address 800 Biting Building Wichita Kansas 67202
Character of Well (completed as Oil, Gas or Dry Hole) Dry hole
Date well completed 1963
Application for plugging filed July 5 1974
Application for plugging approved July 8 1974
Plugging commenced July 18 1974
Plugging completed July 26 1974
Reason for abandonment of well or producing formation dry hole

If a producing well is abandoned, date of last production 19
Was permission obtained from the Conservation Division or its agents before plugging was commenced?

Name of Conservation Agent who supervised plugging of this well Russel Biberstein
Producing formation K. C. lime Depth to top 3892 Bottom 3792 Total Depth of Well 4045 Feet
Show depth and thickness of all water, oil and gas formations.


OIL, GAS OR WATER RECORDS

CASING RECORD

FORMATION	CONTENT	FROM	TO	SIZE	PUT IN	PULLED OUT
	Surface	0	248	8 5/8		
		0	4040	5 1/2		2100

Describe in detail the manner in which the well was plugged, indicating where the mud fluid was placed and the method or methods used in introducing it into the hole. If cement or other plugs were used, state the character of same and depth placed, from feet to feet for each plug set.

Filled with sand to 3600 and dumped 4 sx. cement
Pumped top with 2 sx. hulls 10 sx. jell and 100 sx. cement

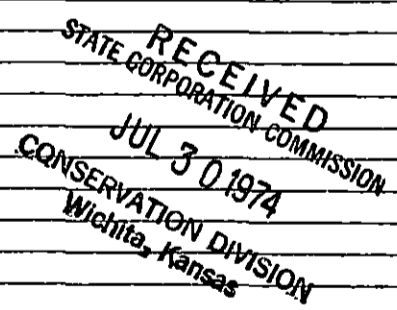


(If additional description is necessary, use BACK of this sheet)

Name of Plugging Contractor Nicholas casing pulling
Address Box 373 Geneseo Kansas

STATE OF Kansas, COUNTY OF Rice, ss.
George A. Nicholas (employee of owner) or (owner or operator) of the above-described well, being first duly sworn on oath, says: That I have knowledge of the facts, statements, and matters herein contained and the log of the above-described well as filed and that the same are true and correct. So help me God.

(Signature) George A. Nicholas

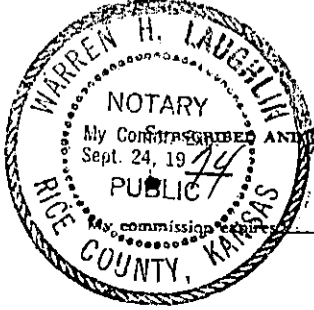

Sworn to before me this 29th day of July 1974
Warren H. Laughlin
Notary Public.

