


WELL PLUGGING RECORD

Give All Information Completely
Make Required Affidavit
Mail or Deliver Report to:
Conservation Division
State Corporation Commission
800 Bitting Building
Wichita, Kansas

Edwards County, Sec. 12 Twp 24 Rge. 16 (W)
Location as "NE/CNW $\frac{1}{4}$ /SW $\frac{1}{4}$ " or footage from lines NE SE NE
Lease Owner Ben C. W. Hyde, Jr.
Lease Name Howell Well No. 1
Office Address 4638 J.C. Nichols Parkway, K. C., 12, Mo.
Character of Well (completed as Oil, Gas or Dry Hole) Dry Hole
Date well completed December 12, 1953.
Application for plugging filed Feb. 7, 1954.
Application for plugging approved Feb. 8, 1954.
Plugging commenced Feb. 8, 1954.
Plugging completed Feb. 12, 1954.

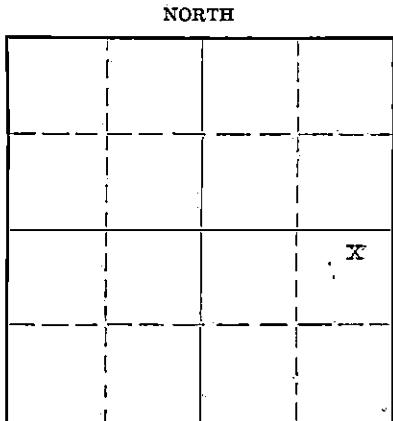

Locate well correctly on above Section Plat

Reason for abandonment of well or producing formation Dry Hole
If a producing well is abandoned, date of last production 19
Was permission obtained from the Conservation Division or its agents before plugging was commenced? Yes

Name of Conservation Agent who supervised plugging of this well M. A. Rives, Box 148, Pratt, Kansas
Producing formation Depth to top Bottom Total Depth of Well Feet
Show depth and thickness of all water, oil and gas formations.

OIL, GAS OR WATER RECORDS

CASING RECORD

Formation	Content	From	To	Size	Put In	Pulled Out

Describe in detail the manner in which the well was plugged, indicating where the mud fluid was placed and the method or methods used in introducing it into the hole. If cement or other plugs were used, state the character of same and depth placed, from feet to feet for each plug set.

3700 to 3670 ft. Sand bridge
3670 to 3645 " 5 Sks., cement with baller
3645 to 240 " Mudded.
240 to 190 " Rock bridge, 25 sks. cement
190 to 20 " Mud.
20 to Cellar 10 Sks., cement.

(If additional description is necessary, use BACK of this sheet)

Correspondence regarding this well should be addressed to Ben C. W. Hyde, Jr.,
Address 4638 J.C. Nichols Parkway, Room 215, Millcreek Bldg., Kansas City 12, Mo.

STATE OF KANSAS, COUNTY OF JOHNSON, ss.
Ben C. W. Hyde, Jr. (owner or operator) of the above-described well,
being first duly sworn on oath, says: That I have knowledge of the facts, statements, and matters herein contained and the log of the above-described well as filed and that the same are true and correct. So help me God.

(Signature) Ben C. W. Hyde, Jr.
4638 J.C. Nichols Parkway, K.C. 12, Mo.
(Address)

SUBSCRIBED AND SWORN to before me this 2nd day of March, 1954.

Eunice O. Trapp
Notary Public.

My commission expires April 11, 1955.

PLUGGING
FILED SEC 12 T 24 R 16W
BOOK PAGE 12 LINE 14

CONSERVATION DIVISION
WICHITA, KANSAS

3-3-54

WELL LOG

T. H. MASTIN, OWNER - Howell #1
 NE/4 SE/4 NE/4 Section 12, Township 24, Range 16W,
 Edwards County, Kansas

Elevation: 2051 DF

Figures indicate bottom of formation
 0 to 75 sand

Pipe Record:

10-3/4" set at 236'
 5-1/2" set at 4089'

150 shale
 330 shale and shells
 473 Red Bed
 520 sand
 979 Red Bed
 1010 Anhydrite
 1610 shale and shells
 1785 salt
 1945 shale and shells
 3695 lime and shale
 3907 lime
 3915 shale and lime
 4043 lime
 4090 Arbuckle
 4090 Rotary Total Depth

TOPS: RBM

Heebner 3516
 Brown Lime 3643
 Kansas City 3655
 Arbuckle 4043

Rotary Commenced 11-27-53
 Completed 12-12-53

STATE OF KANSAS)
 COUNTY OF BARTON) SS

I, W. F. Banks, Drilling Superintendent of the above-described well, being first duly sworn on oath, declare: That I have knowledge of the facts, statements and matters herein contained pertaining to the log of the above-described well, as filed, and that the same are true and correct.

PLUGGING
 FILE SEC 12 T 24 R 16W
 BOOK PAGE 12 LINE 14

W. F. Banks

Subscribed and Sworn to before me this 14th day of December, 1953.

2-8-54

George A Meyer
 Notary Public

My commission expires Feb. 10, 1955.