


STATE OF KANSAS
STATE CORPORATION COMMISSION

Give All Information Completely
Make Required Affidavit
Mail or Deliver Report to:
Conservation Division
State Corporation Commission
800 Biting Building
Wichita, Kansas

WELL PLUGGING RECORD

Edwards County, Sec. 18 Twp. 24 Rge. (E) 16 (W)

Location as "NE/CNW/SW" or footage from lines SE SW SW
Lease Owner Natural Gas & Oil Corp & Oklahoma Exploration
Lease Name Campbell Well No. 1
Office Address 1009 Central Building, Wichita 2, Kansas
Character of Well (completed as Oil, Gas or Dry Hole) dry hole
Date well completed October 9, 1953 19
Application for plugging filed October 10, 1953 (Orally) 19
Application for plugging approved October 12, 1953 (written) 19
Plugging commenced October 10, 1953 19
Plugging completed October 10, 1953 19
Reason for abandonment of well or producing formation

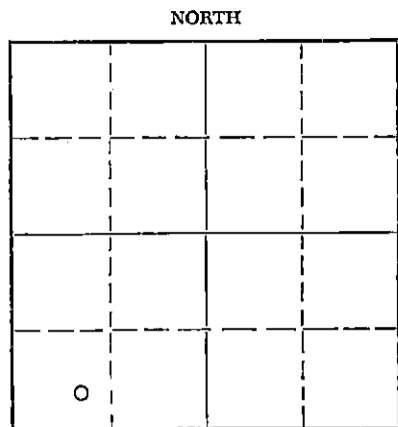

Locate well correctly on above
Section Plat

If a producing well is abandoned, date of last production 19
Was permission obtained from the Conservation Division or its agents before plugging was commenced? yes

Name of Conservation Agent who supervised plugging of this well M. A. Rives, Box 148, Pratt, Kansas
Producing formation Depth to top Bottom Total Depth of Well Feet
Show depth and thickness of all water, oil and gas formations.

OIL, GAS OR WATER RECORDS

CASING RECORD

FORMATION	CONTENT	FROM	TO	SIZE	PUT IN	PULLED OUT
surface		0	207	8 5/8"	207	none

Describe in detail the manner in which the well was plugged, indicating where the mud fluid was placed and the method or methods used in introducing it into the hole. If cement or other plugs were used, state the character of same and depth placed, from feet to feet for each plug set.

Set plug and filled hole with heavy mud from
4640 total depth to 200 feet.
Set plug at 200 feet and ran 20 sacks cement to 140 feet
~~Set plug~~ Filled hole with heavy mud from 140 to 40 feet
Set plug at 40 feet and ran 10 sacks cement to cellar.

(If additional description is necessary, use BACK of this sheet)

Name of Plugging Contractor Drilling Department-Natural Gas and Oil Corporation
Address 1009 Central Building, Wichita 2, Kansas


STATE OF Kansas COUNTY OF Sedgwick, ss.
Harold A. Burt, Regional Manager (employee of owner) or (owner or operator) of the above-described well, being first duly sworn on oath, says: That I have knowledge of the facts, statements, and matters herein contained and the log of the above-described well as filed and that the same are true and correct. So help me God.

(Signature) Harold A. Burt
1009 Central Bldg, Wichita, Kansas
(Address)

SUBSCRIBED AND SWORN TO before me this 13th day of October, 1953

Notary Public.
Esther L. Insell

My commission expires May 25, 1957

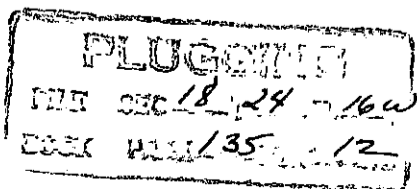

24-7366-5 3-53-20M

OCT 13 1953 10-16-53
CONSERVATION DIVISION
Wichita, Kansas

driller's log

COMPANY: Natural Gas and Oil Corporation and
Oklahoma Exploration Company

CONTRACTOR: Drilling Dept-Natural Gas & Oil Corp

FARM: Campbell #1 SE SW SW Sec. 18-24-16W
Edwards County, Kansas.

COMMENCED: September 21, 1953

COMPLETED: October 10, 1953

ELEVATION: 2093 RB

0	to	15	Clay
15	to	130	Sand
130	to	207	Shale
207	to	375	Shale and shells
375	to	600	Red bed and gyp.
600	to	650	Sand
650	to	930	Red bed
930	to	1108	Red bed and shells
1108	to	1130	Anhydrite
1130	to	2020	Shale and shells
2020	to	2470	Shale and lime
2470	to	2550	Lime
2550	to	3693	Lime and shale
3693	to	3700	Heebner shale
3700	to	3861	Lime and shale
3861	to	4097	Lime
4097	to	4290	Lime and shale
4290	to	4291	Chert
4291	to	4316	Lime
4316	to	4355	Lime, chert and shale
4355	to	4393	Lime and shale
4393	to	4401	Lime
4401	to	4420	Lime and shale
4420	to	4451	Cherty lime
4451	to	4455	Lime
4455	to	4498	Lime W/chert
4498	to	4520	Lime
4520	to	4544	Shale and sandy lime
4544	to	4583	Lime some chert
4583	to	4598	S. Shale and sand
4598	to	4627	Lime and shale
4627	to	4628	Simpson
4628	to	4640	Arbuckle lime
		4640	T. D.

Set 207 feet of 8 5/8" surface. Cemented with 225 sacks cement and 4 sacks calcium chloride.

TOPS:	Anhydrite	1108	Lansing	3823	Viola	4377
	Heebner	3687	Base KC	4107	Simpson	4572
	Brown Lime	3813	Mississ.	4257	Arbuckle	4629

DRILL STEM TESTS:

#1-3954-70, open 1 hr, weak blow, rec. 25' mud, 1280# BHP.

#2-3989-4022, open 1 hr, good blow, rec. 640' sl muddy salt water, IFP 120#, FFP 470#, BHP 1580#.

#3-4248-92, open 1 1/3 hrs, rec. 40' gas cut mud, gas in 45 min, IFP 60#, FFP 60#, BHP 80#.

#4-4425-51, open 45 min, rec. 35' mud, 100# BHP.

#5-4577-98, open 1/2 hr, rec. 135' mud, 740# BHP.

#6-4631-40, open 1 hr, rec. 310' sulphur water, FFP 75# BHP 275#.

Schlumberger run
DRY, PLUGGED AND ABANDONED

PLUGGING
WEL SEC. 18-24-16W
BOOK PAGE 135 LINE 12

OCT 16 1953 10-16-53
CONSERVATION DIVISION
Wichita, Kansas

C E R T I F I C A T E

I, Harold A. Burt, do hereby certify that the above and foregoing is a true and correct copy of the log of the Campbell #1, SE SW SW Section 18-24S-16W, Edwards County, Kansas, as reflected by files of the Natural Gas and Oil Corporation.

Harold A. Burt
Harold A. Burt
Regional Manager

Subscribed and sworn to before me, a Notary Public, within and for Sedgwick County, Kansas, this 13th day of October, 1953.

Esther Unsell
Esther Unsell, Notary Public

My commission expires May 25, 1957.

PLUGGING
FILE SEC 18 T 24 R 16W
BOOK PAGE 135 LINE 12

RECEIVED
STATE CORPORATION COMMISSION
OCT 16 1953
CONSERVATION DIVISION
Wichita, Kansas