

STATE OF KANSAS
STATE CORPORATION COMMISSION

WELL PLUGGING RECORD

Give All Information Completely
Make Required Affidavit
Mail or Deliver Report to:
Conservation Division
State Corporation Commission
211 No. Broadway
Wichita, Kansas

Edwards

County. Sec. 23 Twp. 24s Rge. 17 (E) (W)

Location as "NE/CNW&SW&SE" or footage from lines SW-SW-SE

Lease Owner Hudson Petroleum Company

Lease Name Soeken Well No. 1

Office Address 1112 Southwest Blvd., Kansas City, Kansas

Character of Well (completed as Oil, Gas or Dry Hole) Dry Hole

Date well completed August 18, 1959

Application for plugging filed August 18, 1959


Application for plugging approved 1959

Plugging commenced August 18, 1959

Plugging completed August 18, 1959

Reason for abandonment of well or producing formation Dry Hole

NORTH

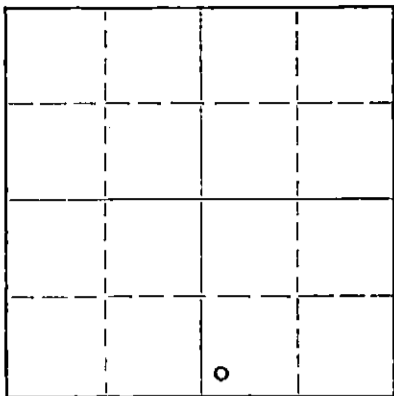

Locate well correctly on above
Section Plat

If a producing well is abandoned, date of last production 19

Was permission obtained from the Conservation Division or its agents before plugging was commenced? Yes

Name of Conservation Agent who supervised plugging of this well Frank Broadfoot

Producing formation Depth to top Bottom Total Depth of Well 4545 Feet

Show depth and thickness of all water, oil and gas formations.

OIL, GAS OR WATER RECORDS

CASING RECORD

FORMATION	CONTENT	FROM	TO	SIZE	PUT IN	PULLED OUT
				8 5/8"	321	

Describe in detail the manner in which the well was plugged, indicating where the mud fluid was placed and the method or methods used in introducing it into the hole. If cement or other plugs were used, state the character of same and depth placed, from feet to feet for each plug set.

Filled hole to 240', set plug with hulls, mixed 20 sacks cement through drill pipe. Filled hole with mud, set plug at 35', mixed 10 sacks cement through drill pipe.

8-21-59
RECEIVED
STATE CORPORATION COMMISSION
AUG 21 1959
CONSERVATION DIVISION
Wichita, Kansas

(If additional description is necessary, use BACK of this sheet)

Name of Plugging Contractor Honaker-Davis Drilling Company

Address 2008 Lakin, Great Bend, Kansas

STATE OF KANSAS, COUNTY OF WYANDOTTE, ss.
H. C. Hopkins (employee of owner) or (owner or operator) of the above-described

well, being first duly sworn on oath, says: That I have knowledge of the facts, statements, and matters herein contained and the log of the above-described well as filed and that the same are true and correct. So help me God.

(Signature) H. C. Hopkins

1112 Southwest Blvd., Kansas City, Kansas
(Address)

SUBSCRIBED AND SWORN TO before me this 20th day of August, 1959

My Commission Expires Feb. 13, 1961

R. L. Erwin
Notary Public.

My commission expires

PLUGG'
FILE SEC. 23 T 24 12th
BOOK PAGE 62 8

DRILLERS' LOG

Soeken No. 1
 Loc: SW SW SE
 Sec: 23-24S-17W
 Edwards County, Kansas
 Company: Hudson Petroleum Company
 Contractor: Honaker-Davis Drlg. Co.

Comm: 8-7-59
 Comp: 8-19-59
 Rotary Total Depth: 4545'
 Casing: 8 5/8" at 321'
 D & A

0	40	Top soil & sand
40	185	Sand & Gravel
185	215	Blue Shale
215	321	Shale
321	435	Shale & Red Bed
435	465	Sand
465	600	Shale & Red Bed
600	660	Sand
660	1115	Shale & Red Bed
1115	1145	Anhydrite
1145	1600	Shale
1600	1995	Red Bed & Shale
1995	3985	Lime & Shale
3985	4037	Lime
4037	4195	Lime & Shale
4195	4246	Lime
4246	4380	Lime & Shale
4380	4500	Lime & Chert
4500	4545	Shale, Lime & Chert
4545		Total Rotary Depth

8 5/8" casing cemented at 321' with 225 sacks cement and 2% calcium chloride.

RECEIVED
 STATE CORPORATION COMMISSION
 8-21-59
 AUG 21 1959
 CONSERVATION DIVISION
 Wichita, Kansas

D & A

I certify that this is the true and correct copy of the above log to the best of my knowledge.

H. S. Forbes

H. S. Forbes

Subscribed and sworn to before me this 19th day of August, 1959.

Kenneth G. Fischer

Kenneth G. Fischer, Notary Public

My commission expires: 6-25-63

PLUGGING
 FILE: SEC 23, T. 24, R. 17W
 BOOK: PAGE 62 LINE 81