


WELL PLUGGING RECORD

Give All Information Completely  
Make Required Affidavit  
Mail or Deliver Report to:  
Conservation Division  
State Corporation Commission  
800 Bittling Building  
Wichita, Kansas

NORTH

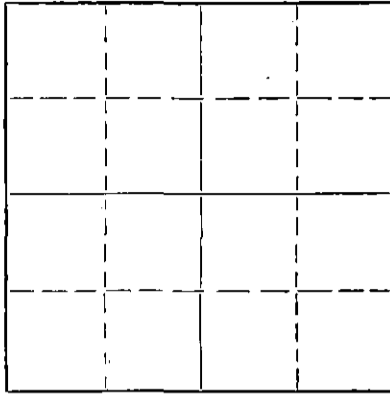

Locate well correctly on above  
Section Plat

Edwards County. Sec. 25 Twp. 24 Rge. (E) 16 (W)

Location as "NE/CNW/SW" or footage from lines SE SE NW  
Lease Owner M. B. Armer  
Lease Name Elmore Well No. 1  
Office Address 710 Petroleum Bldg., Wichita, Kansas  
Character of Well (completed as Oil, Gas or Dry Hole) dry  
Date well completed June 3 19 52  
Application for plugging filed June 3 19 52  
Application for plugging approved June 3 19 52  
Plugging commenced June 3 19 52  
Plugging completed June 3 19 52  
Reason for abandonment of well or producing formation dry

If a producing well is abandoned, date of last production 19  
Was permission obtained from the Conservation Division or its agents before plugging was commenced? yes

Name of Conservation Agent who supervised plugging of this well M. A. Rives  
Producing formation Depth to top Bottom Total Depth of Well 4680 Feet  
Show depth and thickness of all water, oil and gas formations.

OIL, GAS OR WATER RECORDS

CASING RECORD

FORMATION	CONTENT	FROM	TO	SIZE	PUT IN	PULLED OUT
				8-5/8	258	none

Describe in detail the manner in which the well was plugged, indicating where the mud fluid was placed and the method or methods used in introducing it into the hole. If cement or other plugs were used, state the character of same and depth placed, from feet to feet for each plug set.

Filled hole with heavy rotary mud to 240 ft., set plug and cemented with 15 sacks cement through drill pipe. Filled with mud to 35 ft., set plug and cemented with 10 sacks cement to surface.

6-7-52  
STATE CORPORATION COMMISSION  
JUN 7 1952  
CONSERVATION DIVISION

Name of Plugging Contractor M. B. Armer  
Address 710 Petroleum Bldg., Wichita, Kansas

STATE OF Kansas COUNTY OF Sedgwick ss.  
L. C. Sponenberg (employee of owner) or (owner or operator) of the above-described well, being first duly sworn on oath, says: That I have knowledge of the facts, statements, and matters herein contained and the log of the above-described well as filed and that the same are true and correct. So help me God.

(Signature) *L. C. Sponenberg*  
(Address)

SUBSCRIBED AND SWORN TO before me this 6 day of June, 19 52

*Nazel Swanton*  
Notary Public.

My commission expires Sept. 17, 1955

PLUGGING  
FILE SEC 25 T 24 R 16  
BOOK PAGE 21 LINES

LOG

Company: M. B. Armer  
 Contractor: M. B. Armer (Unit)  
 Drilling Commenced: 5/16/52  
 Drilling Completed: 6/4/52  
 Elevation: 2062 D.F.  
 2060 Gr.

Farm: Elmore #1  
 Location: SE SE NW Sec. 25-24-16W  
 Edwards County, Kansas  
 Casing Record: 8-5/8" casing at 258'  
 with 185 sacks cement.

(figures below indicate bottoms)

Sand & surface clay	195
Blue shale & shells	225
Shale	258
Shale & Red bed	880
Anhydrite	930
Shale & shells	1500
Shale, salt & shells	1705
Shale & shells	2080
Shale & lime	3090
Shale	3245
Shale & lime	3885
Lime	4048
Lime & shale	4200
Cherty lime	4228
Lime	4265
Sandy shale	4290
Shale & lime	4428
Cherty lime & shale	4460
Cherty lime	4503
Chert & lime	4515
Cherty lime	4562
Sand & lime	4605
Chert & lime	4635
Lime & cherty streaks	4680
R. T. D.	4680 D. & A.

FORMATION TOPS

Sample (R. R. Meas)		Schlumberger	
Heebner	3663	Heebner	3650
Brown Lime	3795	Brown Lime	3799
Lansing - Kansas City	3805	Lansing - Kansas City	3806
Mississippi Chert	4219	Mississippi	4216
Kinderhook	4254	Kinderhook	4246
Viola	4347	Viola	4348
Simpson	4540	Simpson	4537
Arbuckle	4607	Arbuckle	4606
R.T.D.	4680	R.T.D.	4679

I hereby certify that this is a true and correct log of the above described well as shown by the drilling reports.

6-7-52

M. B. ARMER

By *[Signature]*

RECEIVED  
 STATE CORPORATION COMMISSION  
 JUN 7 - 1952

STATE OF KANSAS )

COUNTY OF SEDGWICK )

ss: *[Signature]*  
 WICHITA, KANSAS

Subscribed and sworn to before me, a notary public, in and for said County and State this 6th day of June, 1952.

*[Signature]*  
 Notary Public

My Commission expires Sept. 17, 1955.

PLUGGING  
 WELL SEC. 25-24-16W  
 ROCK PAGE 21 LINE 15