

CARD MUST BE TYPED

State of Kansas

CARD MUST BE SIGNED ✓

NOTICE OF INTENTION TO DRILL

(see rules on reverse side)

DFA

Expected Spud Date..... November 23, 1987
month day year

API Number 15- 155-21,101-0000

OPERATOR: License # 5238

SE NE Sec 11 Twp. 22 S, Rg. 9 East West
3300 X

Name Petroleum, Inc.

Address 301 N. Main, Suite 900

City/State/Zip Wichita, KS 67202-1508

Contact Person Terry Naylor

Phone 316 793-8471

660 Ft. from South Line of Section
660 Ft. from East Line of Section

(Note: Locate well on Section Plat on reverse side)

Nearest lease or unit boundary line 660 feet

County Reno

Lease Name McVay 'C' Well # 1

CONTRACTOR: License # 5122

Name Woodman-Iannitti Drilling Co.

City/State 1022 Union Center, Wichita, KS 67202

Ground surface elevation feet MSL

Domestic well within 330 feet: yes no

Municipal well within one mile: yes X no

Well Drilled For: Well Class: Type Equipment:

X Oil Storage Infield X Mud Rotary

Gas Inj Pool Ext Air Rotary

OWWO Expl X Wildcat Cable

Depth to bottom of fresh water 200'

Depth to bottom of usable water 200'

Surface pipe by Alternate: 1 X 2 X

If OWWO: old well info as follows:

Surface pipe planned to be set 220'

Operator

Conductor pipe required

Well Name

Projected Total Depth 3850 feet

Comp Date Old Total Depth

Formation Arbuckle

I certify that well will comply with K.S.A. 55-101, et seq., plus eventually plugging hole to KCC specifications.

Date 11-13-87 Signature of Operator or Agent

Title District Landman

For KCC Use:

Conductor Pipe Required feet; Minimum Surface Pipe Required 220 feet per Alt. OK

This Authorization Expires 5-13-88 Approved By R.H.P. 11-13-87


EFFECTIVE DATE: 11-18-87

Must be filed with the K.C.C. five (5) days prior to commencing well
This card void if drilling not started within six (6) months of date received by K.C.C.

Important procedures to follow:

1. Notify District office before setting surface casing.
 2. Set surface casing by circulating cement to the top.
 3. File completion forms ACO-1 with K.C.C. within 120 days of well spud date, following instructions on ACO-1, side 1, and including copies of wireline logs.
 4. Notify District office 48 hours prior to old well workover or re-entry.
 5. Prior to filing Intent, prepare a proposed plugging plan in case well is D & A, then obtain approval of plan when calling district office prior to setting surface pipe.
 6. Submit plugging report (CP-4) to K.C.C. after plugging is completed.
 7. Obtain an approved injection docket number before disposing of salt water.
 8. Notify K.C.C. within 10 days when injection commences or terminates.
- Form alternate 2 completion, cement in the production pipe from below any usable water to surface within 120 days of spud date.

A Regular Section of Land
1 Mile = 5,280 Ft.

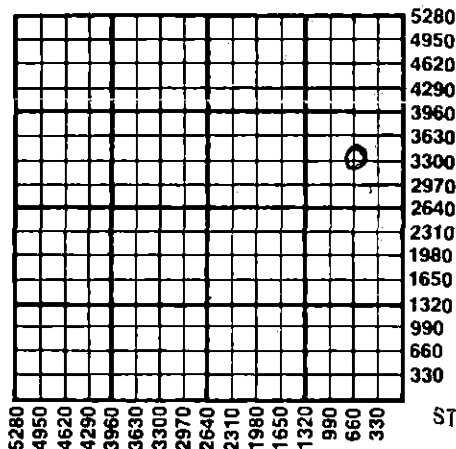

11-13-87

NOV 13 1987

CONSERVATION DIVISION
Wichita, Kansas

State Corporation Commission of Kansas
Conservation Division
200 Colorado Derby Building
Wichita, Kansas 67202-1212
(316) 263-3238