


STATE OF KANSAS
STATE CORPORATION COMMISSION

WELL PLUGGING RECORD

Give All Information Completely
Make Required Affidavit
Mail or Deliver Report to:
Conservation Division
State Corporation Commission
211 No. Broadway
Wichita, Kansas

Barber County. Sec. 20 Twp. 32S Rge. ~~10~~ 10 (W)

Location as "NE/CNW&SW&" or footage from lines SE NE SE
Lease Owner Globe Oil & Refining Co.
Lease Name Schiff-Whelan Gas Unit Well No. 1
Office Address 301 S. Market, Wichita 2, Kansas
Character of Well (completed as Oil, Gas or Dry Hole) Dry Hole
Date well completed October 31 19 57
Application for plugging filed October 31 19 57
Application for plugging approved October 31 19 57
Plugging commenced November 1 19 57
Plugging completed November 1 19 57
Reason for abandonment of well or producing formation

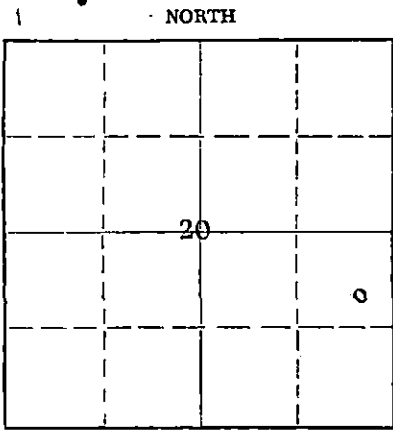

Locate well correctly on above
Section Plot

If a producing well is abandoned, date of last production 19
Was permission obtained from the Conservation Division or its agents before plugging was commenced? Yes

Name of Conservation Agent who supervised plugging of this well Merle Rives
Producing formation Depth to top Bottom Total Depth of Well 4444 Feet
Show depth and thickness of all water, oil and gas formations.

OIL, GAS OR WATER RECORDS

CASING RECORD

FORMATION	CONTENT	FROM	TO	SIZE	PUT IN	PULLED OUT
				8 5/8	230'	None - Cem. w/ 200 sxs.

Describe in detail the manner in which the well was plugged, indicating where the mud fluid was placed and the method or methods used in introducing it into the hole. If cement or other plugs were used, state the character of same and depth placed, from feet to feet for each plug set.

Hole was filled with heavy mud from 4444 feet to 225 feet. Plug was set at 225 feet with 20 sacks cement, then heavy mud to 35 feet. Plug was set at 35 feet, cemented to base of cellar with 10 sacks cement.

11-5-57
RECEIVED
CONSERVATION DIVISION
Wichita, Kan.

(If additional description is necessary, use BACK of this sheet)

Name of Plugging Contractor Walters Drilling Co.
Address Wichita, Kansas

STATE OF Kansas, COUNTY OF Sedgwick, ss.
Leo Ross (employee of owner) or (owner) of the above-described well, being first duly sworn on oath, says: That I have knowledge of the facts, statements, and matters herein contained and the log of the above-described well as filed and that the same are true and correct. So help me God.

(Signature) Leo Ross
301 S. Market, Wichita 2, Kansas (Address)

SUBSCRIBED AND SWORN to before me this 4th day of November, 19 57

Frances Leslie
Notary Public.

My commission expires July 21, 1958

PLUGGING
FILE SEC 20 T 32 R 10 W
BOOK PAGE 59 LINE 1

