


15-007-20636-0000

STATE OF KANSAS  
STATE CORPORATION COMMISSION

WELL PLUGGING RECORD

Give All Information Completely  
Make Required Affidavit  
Mail or Deliver Report to  
Conservation Division  
State Corporation Comm.  
245 North Water  
Wichita, KS 67202

Reno County, Sec. 20 Twp. 32S Rge. 10 ~~NE~~W  
Location as "NE/CNW $\frac{1}{4}$ SW $\frac{1}{4}$ " or footage from lines  
700'SNL & 600'EWL NE/4  
Lease Owner Bill J. Dutton Oil Company  
Lease Name McKeever Well No. 1  
Office Address 620 1st National Center, Hutchinson, Ks  
Character of Well (Completed as Oil, Gas or Dry Hole) \_\_\_\_\_

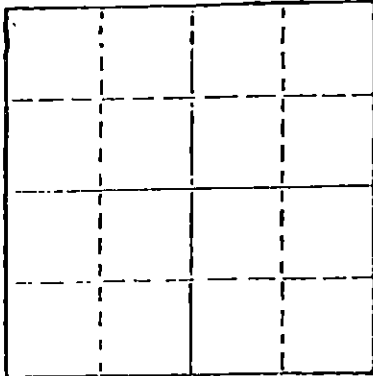

Locate well correctly on above  
Section Plot

dry hole  
Date Well completed 6-30 1978  
Application for plugging filed 6-30 1978  
Application for plugging approved 6-30 1978  
Plugging commenced 6-30 1978  
Plugging completed 6-30 1978

Reason for abandonment of well or producing formation  
no commercial quantities of oil or gas encountered  
If a producing well is abandoned, date of last production  
\_\_\_\_\_ 19\_\_\_\_

Was permission obtained from the Conservation Division or  
its agents before plugging was commenced? yes

Name of Conservation Agent who supervised plugging of this well Bill Owens  
Producing formation \_\_\_\_\_ Depth to top \_\_\_\_\_ Bottom \_\_\_\_\_ Total Depth of Well 4425  
Show depth and thickness of all water, oil and gas formations.

OIL, GAS OR WATER RECORDS

CASING RECORD

FORMATION	CONTENT	FROM	TO	SIZE	PUT IN	PULLED OUT
surface hole	shale	surf	248	8-5/8"	238	none

Describe in detail the manner in which the well was plugged, indicating where the mud fluid  
was placed and the method or methods used in introducing it into the hold. If cement or other  
plugs were used, state the character of same and depth placed, from \_\_\_\_\_ feet to  
\_\_\_\_\_ feet for each plug set.

plug  
Fluid to 1070', /35 sx  
Fluid to 40', plug, 12 sx  
3 sx in rat hole

RECEIVED  
STATE CORPORATION COMMISSION

JUL 07 1979

7-7-78

CONSERVATION DIVISION  
Wichita, Kansas

(If additional description is necessary, use BACK of this sheet)

Name of Plugging Contractor D N B DRILLING, INC.  
515 R. H. Garvey Building

Wichita, Kansas 67202

STATE OF Kansas COUNTY OF Sedgwick, ss.

Ella Priess (employee of owner) or (owner or operator)

of the above-described well, being first duly sworn on oath, says: That I have knowledge of  
the facts, statements, and matters herein contained and the log of the above-described well  
as filed and that the same are true and correct. So help me God.

(Signature)

Ella Priess

Suite 515, R. H. Garvey Bldg., Wichita, Ks.  
(Address) 67202

SUBSCRIBED AND SWORN TO before me this 6th day of July, 1978

My commission expires 4/30/79

Dorothy L. Schmidt  
Dorothy L. Schmidt Notary Public.

DOROTHY L. SCHMIDT  
STATE NOTARY PUBLIC  
Sedgwick County, Kansas  
My Appt. Exp. April 30, 1979

DRILLERS' LOG

BILL J. DUTTON OIL COMPANY  
 No. 1 McKeever  
 700' SNL & 600' EWL NE/4  
 Sec/ 20-32S-10W  
 Barber Co., Ks.

RECEIVED  
 STATE CONSERVATION COMMISSION

JUL 07 1978 7-7-78

CONSERVATION DIVISION  
 Wichita, Kansas

Commenced: 6-23-78  
 Completed: 6-30-78

Surface Casing: 238' of 8-5/8"  
 cemented w/275 sx common, 3% cc,  
 2% gel. 6-23-78

FORMATIONDEPTH

Surface Hole	0 - 248
Red Bed & Shale	248 - 720
Shale & Shells	720 - 1560
Shale & Lime	1560 - 2775
Lime & Shale	2775 - 3965
Shale & Lime	3965 - 4171
Lime & Shale	4171 - 4318
Lime	4318 - 4425 RTD

I do hereby certify that the foregoing statements are true and correct to the best of my knowledge and belief.

D N B DRILLING, INC.

*Ella Priess*

Ella Priess

STATE OF KANSAS: ss:

Subscribed and sworn to before me this 6th day of July, 1978.

*Dorothy L. Schmidt*  
 Dorothy L. Schmidt, Notary Public

DOROTHY L. SCHMIDT  
 STATE NOTARY PUBLIC  
 Sedgwick Count., Kansas  
 My Appt. Exp. April 30, 1979