


STATE OF KANSAS
STATE CORPORATION COMMISSION

15-155-00119-0000
WELL PLUGGING RECORD

Give All Information Completely
Make Required Affidavit
Mail or Deliver Report to:
Conservation Division
State Corporation Commission
212 North Market, Insurance Bldg.
Wichita, Kansas

NORTH

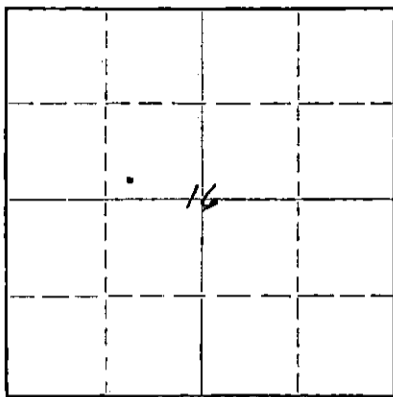

Locate well correctly on above
Section Plat

Reno County, Sec. 16 Twp. 22S Rge. (E) 5 (W)
Location as "NE/CNW/SW" or footage from lines 330'N 990'W of Center
Lease Owner Cities Service Oil Company
Lease Name Ekhölm Well No. 1
Office Address Box 31, Augusta, Kansas
Character of Well (completed as Oil, Gas or Dry Hole) Dry Hole
Date well completed 11-28 1960
Application for plugging filed 11-28 1960
Application for plugging approved 11-29 1960
Plugging commenced 11-29 1960
Plugging completed 11-29 1960
Reason for abandonment of well or producing formation Drilled and abandoned -
Dry Hole

If a producing well is abandoned, date of last production 19
Was permission obtained from the Conservation Division or its agents before plugging was com-
menced? Yes

Name of Conservation Agent who supervised plugging of this well Fred Hampel, Pretty Prairie
Producing formation _____ Depth to top _____ Bottom _____ Total Depth of Well 4100 Feet
Show depth and thickness of all water, oil and gas formations.

OIL, GAS OR WATER RECORDS

CASING RECORD

FORMATION	CONTENT	FROM	TO	SIZE	PUT IN	PULLED OUT

Describe in detail the manner in which the well was plugged, indicating where the mud fluid was placed and the method or methods used in introducing it into the hole. If cement or other plugs were used, state the character of same and depth placed, from _____ feet to _____ feet for each plug set.

Mud from 4100' to 240' - 1/4 sack hulls at 240' - dump 15 sacks cement thru drill pipe at 240' - mud to 35' - 1/4 sack hulls at 35' - 10 sacks cement to surface plug rat hole with 2 sacks cement.

RECEIVED
STATE CORP. COMMISSION

DEC 7 1960

CONSERVATION DIVISION
WICHITA, KANSAS

12-7-60

(If additional description is necessary, use BACK of this sheet)

Name of Plugging Contractor Prime Drilling Company
Address Union Center, Wichita, Kansas

STATE OF KANSAS, COUNTY OF BUTLER, ss.
E. W. Peterman (employee of owner) or (owner or operator) of the above-described well, being first duly sworn on oath, says: That I have knowledge of the facts, statements, and matters herein contained and the log of the above-described well as filed and that the same are true and correct. So help me God.

(Signature) E. W. Peterman
Box 31, Augusta, Kansas
(Address)

SUBSCRIBED AND SWORN TO before me this 6th day of December, 19 60

My commission expires March 12th, 1962 Glen R. Carmack Notary Public.



Am

ROTARY DRILLING LOG

OPERATOR: Cities Service Oil Company
 #1 Ekholm
 C SW SE NW Sec. 16-22-5W,
 Reno County, Kansas

CONTRACTOR: Prime Drilling Company
 COM: 11-16-60
 COMP: 11-29-60

Remarks: Set 8-5/8" casing at 247'
 cemented with 200 sacks
 cement.

Formations:

Shale-Red Bed Shale	210'
Shale & Shells	600'
Salt & Shale	780'
Shale	850'
Anhydrite	900'
Lime & Shale	1115'
Shale & Lime	1315'
Lime	1535'
Shale & Lime	1820'
Shale	2100'
Shale & Lime	2355'
Lime	2640'
Douglas	2725'
Lime	2800'
Lime & Shale	2830'
Lime	3357'
Lime & Shale	3415'
Shale	3425'
Lime & Shale	3470'
Lime	3518'
Chert	3553'
Lime	3615'
Cherty Lime	3683'
Lime	3715'
Lime & Shale	3840'
Sandy Shale	3844'
Lime	3874'
Shale	3969'
Lime	3992'
Sand	4071'
Arbuckle	4100'
Rotary Total Depth (DSA)	4100'

12-7-60

We certify the above log is true
 and correct to the best of our
 knowledge and belief.

PRIME DRILLING COMPANY

R. R. McNicol

R. R. McNicol

[Handwritten mark]