


STATE OF KANSAS
STATE CORPORATION COMMISSION

15-155-00435-0000
WELL PLUGGING RECORD

Give All Information Completely
Make Required Affidavit
Mail or Deliver Report to:
Conservation Division
State Corporation Commission
800 Biting Building
Wichita, Kansas

Reno County, Sec. 22 Twp. 22S Rge. 5W (E) (W)
Location as "NE/CNW/SW" or footage from lines. NE NE SW
Lease Owner Braden Drilling Company
Lease Name Stoughton Well No. 1
Office Address 1017 Union National Bank Bldg., Wichita, Kansas
Character of Well (completed as Oil, Gas or Dry Hole) Dry Hole
Date well completed September 19, 1952 19
Application for plugging filed September 18, 1952 19
Application for plugging approved September 23, 1952 19
Plugging commenced September 19, 1952 19
Plugging completed September 19, 1952 19
Reason for abandonment of well or producing formation _____

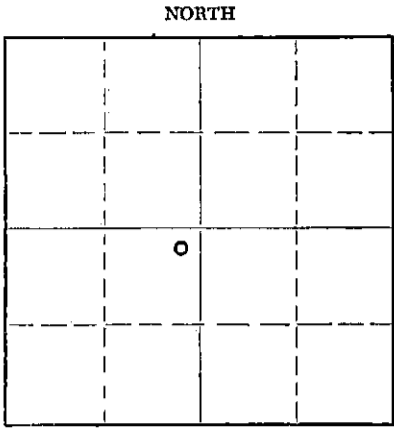

Locate well correctly on above Section Plat

If a producing well is abandoned, date of last production _____ 19
Was permission obtained from the Conservation Division or its agents before plugging was commenced? Yes

Name of Conservation Agent who supervised plugging of this well Ruel Durkee
Producing formation _____ Depth to top _____ Bottom _____ Total Depth of Well 4116 Feet
Show depth and thickness of all water, oil and gas formations.

OIL, GAS OR WATER RECORDS

CASING RECORD

FORMATION	CONTENT	FROM	TO	SIZE	PUT IN	PULLED OUT
				8-5/8"	165	

Describe in detail the manner in which the well was plugged, indicating where the mud fluid was placed and the method or methods used in introducing it into the hole. If cement or other plugs were used, state the character of same and depth placed, from _____ feet to _____ feet for each plug set.

Gunned pits and pumped hole full of heavy rotary mud. Laid down half of drill pipe and filled hole with heavy mud. Circulated thirty minutes and laid down the rest of drill pipe. Pushed bottom plug to 150 feet. Dumped 15 sacks of cement on plug through the drill pipe and set top plug at 20 feet. Dumped 1/2 sack of hulls and 5 sacks of cement filling to surface.

RECEIVED
STATE CORPORATION COMMISSION

SEP 25 1952

CONSERVATION DIVISION
Wichita, Kansas

9-25-52

(If additional description is necessary, use BACK of this sheet)

Name of Plugging Contractor Braden Drilling Company
Address 1017 Union National Bank Bldg., Wichita, Kansas

STATE OF KANSAS, COUNTY OF SEDGWICK, ss.
Louis E. Potucek (employee of owner) or (~~owner or operator~~) of the above-described

well, being first duly sworn on oath, says: That I have knowledge of the facts, statements, and matters herein contained and the log of the above-described well as filed and that the same are true and correct. So help me God.

(Signature) Louis E. Potucek

1017 Union National Bank Bldg., (Address)

SUBSCRIBED AND SWORN TO before me this 25th day of September, 1952.

My commission expires My Commission Expires Jan. 31, 1953 Edward S. Greider Notary Public.

PLUGGING
FILE SEC 22 T 22 R 5W
BOOK PAGE 46 LINE 28

15-155-00435-0000

Stoughton #1

Operator: Braden Drilling Co.

Contractor: Braden Drilling Co.

Sec: 22-22-5W

NE NE SW

Rice County, Kansas

Elevation: 1567 DF

Test commenced: 9-3-52

Test completed: 9-19-52

Casing Records:

8-5/8" 165'. Cemented with L40 sacks.

Sand & Shale	120
Red Bed & Shells	165
Shale & Shells	450
Salt	550
Red Bed	590
Red Bed Shells	650
Shale & Shells	925
Lime	950
Shale & Shells	1125
Lime & Shale	1165
Shale & Lime Shells	1280
Lime	1370
Shale & Shells	1810
Lime & Shale	1900
Shale & Shells	2325
Lime & Shale	2360
Lime	2630
Lime-Shale	2785
Lime	2860
Lime & Shale	2955
Lime	3475
Conglomerate	3487
Cherty Lime	3515
Lime	3580
Chert & Lime	3660
Cherty Lime	3685
Chert & Lime	3700
Shale	3705
Shale & Shells	3755
Shale & Lime	3815
Shale	3850
Lime	3920
Shale & Lime	3990
Sand & Shale	3994
Lime & Shale	4030
Sand & Iron	4032
Lime	4095
Shale & Lime	4116

PLUGGING

WELL NO. 22-22-5W

BOOK PAGE 46 LINE 28

RECEIVED
STATE CORPORATION COMMISSION
SEP 25 1952
CONSERVATION DIVISION
Wichita, Kansas

9-25-52

T. D. R.B.

STATE OF KANSAS, SEDGWICK COUNTY, SS:

I hereby certify that the above information is true and correct as revealed by the records of the Braden Drilling Co.

James B. Hessler

Subscribed and sworn to before me this 23rd day of September, 1952.

Donald F. Paterek
Notary Public.

My commission expires: Feb. 13, 1954