


STATE OF KANSAS
STATE CORPORATION COMMISSION

Form CP-4

15-155-20040-0000
WELL PLUGGING RECORD

Give All Information Completely
Make Required Affidavit
Mail or Deliver Report to:
Conservation Division
State Corporation Commission
212 No. Market
Wichita, Kansas

NORTH

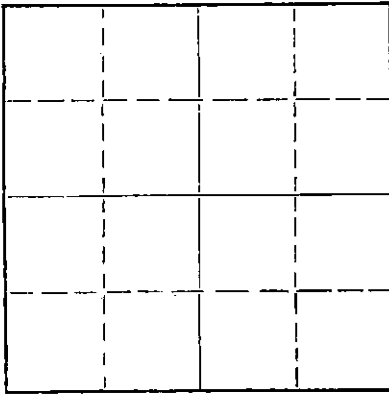

Locate well correctly on above
Section Plat

Reno County, Sec. 34 Twp. 22S Rge. 6 (E) W (W)

Location as "NE/CNW/SW" or footage from lines NE SE NE

Lease Owner Petroleum Management, Inc.

Lease Name Nelson Well No. 1

Office Address 1515 Wichita Plaza Wichita, Kansas

Character of Well (completed as Oil, Gas or Dry Hole) D & A

Date well completed January 4 19 68

Application for plugging filed January 4 19 68

Application for plugging approved January 4 19 68

Plugging commenced January 4 19 68

Plugging completed January 4 19 68

Reason for abandonment of well or producing formation D & A

If a producing well is abandoned, date of last production 19

Was permission obtained from the Conservation Division or its agents before plugging was commenced? Yes

Name of Conservation Agent who supervised plugging of this well Gilbert Toman

Producing formation Depth to top Bottom Total Depth of Well 4061 Feet

Show depth and thickness of all water, oil and gas formations.

OIL, GAS OR WATER RECORDS

CASING RECORD

FORMATION	CONTENT	FROM	TO	SIZE	PUT IN	PULLED OUT
				8 5/8"	208'	-0-

Describe in detail the manner in which the well was plugged, indicating where the mud fluid was placed and the method or methods used in introducing it into the hole. If cement or other plugs were used, state the character of same and depth placed, from feet to feet for each plug set.

Fill hole w/mud to 200'
1/2 sx hulls, plug, 25 sx
cem, mud to 40'; 1/2 sx hulls
plug cem to base of cellar
1/2 sx hulls in rat hole

RECEIVED
STATE CORPORATION COMMISSION
JAN 10 1968
CONSERVATION DIVISION
Wichita, Kansas

(If additional description is necessary, use BACK of this sheet)

Name of Plugging Contractor Red Tigef Drilling Company 1-10-68

Address 1720 Wichita Plaza Wichita, Kansas

STATE OF KANSAS, COUNTY OF SEDGWICK, ss.
Maxine V. Starr (employee of owner) or (owner or operator) of the above-described well, being first duly sworn on oath, says: That I have knowledge of the facts, statements, and matters herein contained and the log of the above-described well as filed and that the same are true and correct. So help me God.

(Signature) Maxine V. Starr
1720 Wichita Plaza, Wichita, Kansas
(Address)

SUBSCRIBED AND SWORN TO before me this 8th day of January, 19 68

My commission expires 3-22-71

Betty M. Maloney Notary Public.

15-155-20040-0000
RECEIVED

JAN 09 1968

DRILLERS LOG

Nelson No. 1

CASING RECORD: 8 5/8" @ 208' w/175 sx cement
 COMPANY: Petroleum Management, Inc.
 CONTRACTOR: Red Tiger Drilling Company
 COMMENCED: December 21, 1967
 COMPLETED: January 5, 1968
 TOTAL DEPTH: 4061'
 DESCRIPTION: NE SE NE 34-228-6W Reno Co., Ks.
 ELEVATION:

FORMATION	FROM	TO	REMARKS
Surface soil, Clay	0	8	
Sand	8	75	
Red Bed & Shale	75	209	
Shale, Gyp. & Salt	209	620	
Shale & Shells	620	847	
Lime & Shale	847	1020	
Lime, Shale & Salt	1020	1335	
Lime & Shale	1335	2360	
Lime	2360	2664	
Heebner	2664	2670	
Lime & Shale	2670	2713	
Douglas (Shale, Lime, Sand)	2713	2800	
Lime	2800	3340	
Lime and Shale	3340	3528	
Mississippi	3528	3640	
Chert and Lime	3640	3670	
Lime	3670	3687	
Lime & Shale	3687	3858	
Lime	3858	3905	
Viola	3905	3965	
Simpson	3965	3995	
Simpson, Shale & Sand	3995	4000	
Simpson	4000	4055	
Arbuckle	4055	4061	

RECEIVED
 STATE CORPORATION COMMISSION
 JAN 10 1968
 CONSERVATION DIVISION
 Wichita, Kansas

1-10-68

I certify that this is a true and correct copy of the above log to the best of my knowledge.

RED TIGER DRILLING COMPANY

Maxine V. Starr
 Maxine V. Starr

Subscribed and sworn to before me this 8th day of January, 1968.

Ruth M. Maloney
 Notary Public

My Commission Expires:

3-22-71