


STATE OF KANSAS
STATE CORPORATION COMMISSION

Give All Information Completely
Make Accurate Study of
Well or Wells Report to
Conservation Division
State Corporation Commission

P. O. Box 17027
Wichita, Kansas 67217

WELL PLUGGING RECORD

Reno County, Sec. 4 Twp. 22S Rge. 7W (BX) (W)
Location as "NE/CNW/SE" or footage from lines NE NE NW
Lease Owner Gemini Oil Company
Lease Name Rampenthal Well No. 1
Office Address 1108 Philtower Building, Tulsa, Oklahoma 74103
Character of Well (completed as Oil, Gas or Dry Hole) Dry Hole
Date well completed February 18, 1975 19
Application for plugging filed February 18, 1975 19
Application for plugging approved February 18, 1975 19
Plugging commenced 8:15 AM, February 18, 1975 19
Plugging completed 10:15 AM, February 18, 1975 19
Reason for abandonment of well or producing formation Dry Hole

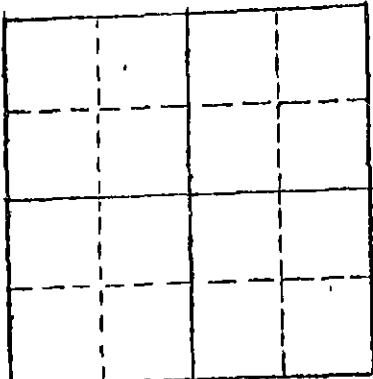

Locate well correctly on above
Section Plat

If a producing well is abandoned, date of last production 19
Was permission obtained from the Conservation Division or its agents before plugging was commenced? Yes

Name of Conservation Agent who supervised plugging of this well Gilbert Toman
Producing formation _____ Depth to top _____ Bottom _____ Total Depth of Well 3306 Feet
Show depth and thickness of all water, oil and gas formations.

OIL, GAS OR WATER RECORDS

CASING RECORD

FORMATION	CONTENT	FROM	TO	SIZE	PUT IN	PULLED OUT
				8 5/8"	200.60'	None

Describe in detail the manner in which the well was plugged, indicating where the mud fluid was placed and the method or methods used in introducing it into the hole. If cement or other plugs were used, state the character of same and depth placed, from _____ feet to _____ feet for each plug set.

Filled hole to 190' with heavy mud.
Pushed 1/4 sack hulls and plug to 190' and dumped 25 sacks cement.
Filled hole to 40" and 1/4 sack hulls and solid plug. Dumped 10 sacks cement to surface, 2 sacks in rat hole.

RECEIVED
STATE CORPORATION COMMISSION
MAR 3 1975
3-3-75
CONSERVATION DIVISION
Wichita, Kansas

(If additional description is necessary, use BACK of this sheet)
Name of Plugging Contractor Sterling Drilling Company
Address P. O. Box 129, Sterling, Kansas 67579

STATE OF KANSAS COUNTY OF RICE ss.
F. A. Wuellner (employee of owner) or (owner or operator) of the above-described well, being first duly sworn on oath, says: That I have knowledge of the facts, statements, and matters herein contained and the log of the above-described well as filed and that the same are true and correct. So help me God. STERLING DRILLING COMPANY

(Signature) *F. A. Wuellner*
F. A. Wuellner, Secretary
P. O. Box 129, Sterling, Kansas 67579

Subscribed and Sworn to before me this 25th day of February 1975

Bernard Laudermilk
Bernard Laudermilk, Notary Public.

15-155-20263-0000

STERLING DRILLING COMPANY
P. O. Box 129
Sterling, Kansas 67579

WELL LOG - - - - - RAMPENTHAL #1
Located: NE NE NW, Section 4-22S-7W, Reno County, Kansas

OWNER: Gemini Oil Company
ROTARY DRILLING CONTRACTOR: Sterling Drilling Company

COMMENCED: January 22, 1975
COMPLETED: February 18, 1975

TOTAL DEPTH: 3306'

LOG	CASING RECORD
0 - 207 Sand, Clay, Shale	Ran 6 joints 8 5/8" 28# used seamless casing, 189.60' pipe set at 200.60 KB. Cemented with 160 sacks 60/40 Pozmix with 2% gel and 3% cc. Plug down at 1:05 AM, 1-22-75.
207 - 1145 Shale	
1145 - 1435 Shale and Lime	
1435 - 1885 Shale	
1885 - 2955 Lime and Shale	
2955 - 3306 Lime	Plugged.

RECEIVED
STATE CORPORATION COMMISSION
MAR 3 1975
CONSERVATION DIVISION
Wichita, Kansas
3-3-75