

15-155-20228-0000

STATE OF KANSAS
STATE CORPORATION COMMISSION


Form CP-4

Give All Information Completely
Make Required Affidavit
Mail or Deliver Report to:
Conservation Division
State Corporation Commission

WELL PLUGGING RECORD

P. O. Box 17027
Wichita, Kansas 67217
NORTH

Reno County, Sec. 17 Twp. 22S Rge. (E) 7 (W)
Location as "NE/CNWxSWx" or footage from lines SW, SW, NW
Lease Owner TransAmerica Oil Corporation
Lease Name Gossage Well No. 2
Office Address Box 518, Hutchinson, Kansas
Character of Well (completed as Oil, Gas or Dry Hole) D & A
Date well completed January 25, 1974 19 74
Application for plugging filed April 5, 1974 19 74
Application for plugging approved Phone Call January 25 19 74
Plugging commenced January 25 19 74
Plugging completed January 25 19 74
Reason for abandonment of well or producing formation No oil or Gas
Dry

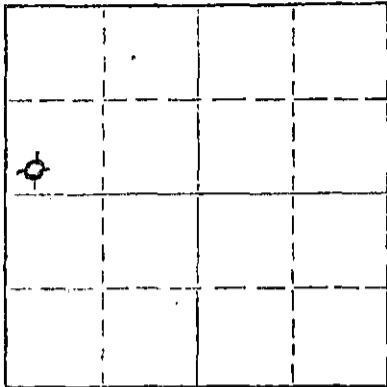

Locate well correctly on above
Section Plat

If a producing well is abandoned, date of last production _____ 19 ____
Was permission obtained from the Conservation Division or its agents before plugging was commenced? Yes, Phone Call

Name of Conservation Agent who supervised plugging of this well Gilbert Jolland
Producing formation Mississippi Depth to top 3,625 Bottom 3,681 Total Depth of Well 3,681 Feet
Show depth and thickness of all water, oil and gas formations.

OIL, GAS OR WATER RECORDS

CASING RECORD

FORMATION	CONTENT	FROM	TO	SIZE	PUT IN	PULLED OUT
Sand		0 - 80'	80'			
Shale		80'	112'			
Red Rock			200'	8 5/8	250	Left in

Describe in detail the manner in which the well was plugged, indicating where the mud fluid was placed and the method or methods used in introducing it into the hole. If cement or other plugs were used, state the character of same and depth placed, from _____ feet to _____ feet for each plug set.

Cement pluggs were used. Mud down 240' Wood plug with sack of hulls on top, then 25 sacks cement.

Top plug 40 from surface then 10 sacks cement

Two sacks cement in rat hole.

RECEIVED
STATE CORPORATION COMMISSION

APR 9 - 1974 4-9-74

CONSERVATION DIVISION
Wichita, Kansas

(If additional description is necessary, use BACK of this sheet)
Name of Plugging Contractor Trans America Oil Corporation
Address Box 518, Hutchinson, Kansas

STATE OF Kansas, COUNTY OF Reno, ss.

Harold D. Brown (employee of owner) or (owner or operator) of the above-described well, being first duly sworn on oath, says: That I have knowledge of the facts, statements, and matters herein contained and the log of the above-described well as filed and that the same are true and correct. So help me God.

(Signature) Harold D. Brown
Box 518, Hutchinson, Kansas
(Address)

SUBSCRIBED AND SWORN TO before me this 5th day of April, 19 74

My commission expires January 12, 1977

Judy L. Niekoff
JUDY L. NIEKOFF
STATE NOTARY PUBLIC
Reno County, Ks.
My Comm. Expires Jan. 12, 1977
Notary Public.