


WELL PLUGGING RECORD

Give All Information Completely  
Make Required Affidavit  
Mail or Deliver Report to:  
Conservation Division  
State Corporation Commission  
211 No. Broadway  
Wichita, Kansas

RENO County. Sec. 19 Twp. 22s Rge. 8w ~~08w~~ (W)

NORTH

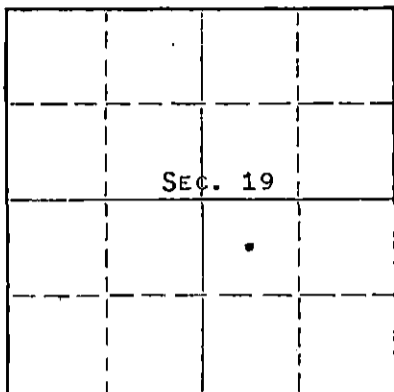

Locate well correctly on above  
Section Plat

Location as "NE/CNW/SW" or footage from lines C NW SE  
Lease Owner PETROLEUM, INC.  
Lease Name SCHMUCKER "D" Well No. 1  
Office Address ROUTE 2, GREAT BEND, KANSAS  
Character of Well (completed as Oil, Gas or Dry Hole) DRY HOLE  
Date well completed JULY 13, 1963  
Application for plugging filed JULY 13, 1963  
Application for plugging approved JULY 13, 1963  
Plugging commenced JULY 13, 1963  
Plugging completed JULY 13, 1963  
Reason for abandonment of well or producing formation NO PRODUCIBLE FORMATIONS

If a producing well is abandoned, date of last production NONE 19    
Was permission obtained from the Conservation Division or its agents before plugging was commenced? YES

Name of Conservation Agent who supervised plugging of this well GILBERT TOMAS  
Producing formation --- Depth to top --- Bottom --- Total Depth of Well 3608 Feet  
Show depth and thickness of all water, oil and gas formations.

OIL, GAS OR WATER RECORDS

CASING RECORD

FORMATION	CONTENT	FROM	TO	SIZE	PUT IN	PULLED OUT
				8-5/8"	214*	NONE

Describe in detail the manner in which the well was plugged, indicating where the mud fluid was placed and the method or methods used in introducing it into the hole. If cement or other plugs were used, state the character of same and depth placed, from \_\_\_\_\_ feet to \_\_\_\_\_ feet for each plug set.

MUDDED UP WITH HEAVY MUD TO 205', FOLLOWED BY WOODEN PLUG AND 1/4 SACK HULLS. PLACED 20 SACKS CEMENT THROUGH DRILL PIPE ONTO HULLS. MUDDED UP WITH HEAVY MUD TO 40', FOLLOWED BY WOODEN PLUG, 1/4 SACK HULLS AND 10 SACKS CEMENT TO BASE OF WELL CELLAR. BRIDGED RAT HOLE WITH 2 SACKS CEMENT

7-23-63

RECEIVED  
STATE CORPORATION COMMISSION

JUL 23 1963

CONSERVATION DIVISION  
Wichita, Kansas

(If additional description is necessary, use BACK of this sheet)  
Name of Plugging Contractor GARVEY DRILLING COMPANY  
Address ROUTE #2, GREAT BEND, KANSAS

STATE OF KANSAS, COUNTY OF BARTON, ss.  
DON SEARLE (employee of owner) or (~~owner~~) of the above-described well, being first duly sworn on oath, says: That I have knowledge of the facts, statements, and matters herein contained and the log of the above-described well as filed and that the same are true and correct. So help me God. DON SEARLE, DIST. PROD. SUPT.  
(Signature)

ROUTE 2, GREAT BEND, KANSAS  
(Address)

SUBSCRIBED AND SWORN TO before me this 19TH day of JULY, 1963

My commission expires APRIL 14, 1967  
Arthur J. Wiles Notary Public.

WELL LOG 15-155-02002-0000

COMPANY Petroleum Incorporated

SEC. 19 T.22S R. 8W

FARM Schmucker

NO. D-1

LOC. NW SE

TOTAL DEPTH 3608'

COUNTY Reno

COMM. 7-5-63

COMP. 7-13-63

CONTRACTOR Garvey Drilling Company

		0	

CASING 8 5/8" @ 214' w/275 sx

ELEVATION 1707' KB

PRODUCTION D & A

FIGURES INDICATE BOTTOM OF FORMATIONS

- 40' Surface Soil
- 90' Clay and Sand
- 185' Sand and Gravel
- 215' Red Bed
- 295' Red Bed and Shale
- 315' Anhydrite
- 1400' Shale
- 1528' Lime and Shale
- 2080' Lime
- 2275' Shale and Lime Streaks
- 2540' Shale and Lime
- 2760' Lime and Shale
- 2965' Lime
- 3115' Shale and Lime
- 3570' Lime
- 3608' Conglomerate
- 3608' RTD

7-23-63  
**RECEIVED**  
 STATE CORPORATION COMMISSION  
 JUL 23 1963  
 CONSERVATION DIVISION  
 Wichita, Kansas

State of Kansas }  
 County of Barton } SS

I, Sam N. Stephens of Garvey Drilling Company  
 upon oath state the above and foregoing is a true and correct copy of the log of the Schmucker D-1 well.

Sam N. Stephens

Subscribed and sworn to before me this 18th day of July 19 63

My Commission Expires: April 14th, 1967

Archer J. Wiles  
 NOTARY PUBLIC