


STATE OF KANSAS  
STATE CORPORATION COMMISSION  
200 Colorado Derby Bldg.  
Wichita, Kansas 67202

Form CP-4  
Rev. 12-15-80

WELL PLUGGING RECORD

Give All Information Completely  
Make Required Affidavit

COUNTY RENO SEC. 19 TWP. 22S RGE. 8  W  
Location as in quarters or footage from lines:  
C-NW-SW

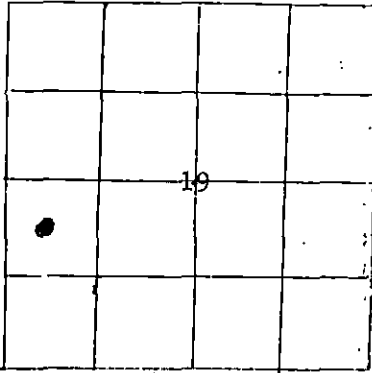

Locate Well  
correctly on above  
Section Platt.

Lease Owner Eagle Explorations, Inc.  
Lease Name Rupp Well No. 1  
Office Address 300, 107 N. Market, Wichita, Kansas  
Character of Well (Completed as Oil, Gas or Dry Hole): Dry  
Date Well Completed July 31, 1981  
Application for plugging filed November 12, 1982  
Plugging commenced February 14, 1983  
Plugging completed February 15, 1983  
Reason for abandonment of well or producing formation  
Non Commercial Quantities of Hydrocarbons  
Was permission obtained from the Conservation Division or it's  
Agent's before plugging was commenced? Yes

Name of Conservation Agent who supervised plugging of this well Don Thompson  
Producing formation Mississippian Depth to top 3579' bottom 3588' T.D. 4000'  
Show depth and thickness of all water, oil and gas formations.

OIL, GAS OR WATER RECORDS

Casing Record

Formation	Content	From	To	Size	Put in	Pulled Out
Surface Pipe		0	301'	8 5/8"		
Production Casing		0	3999'	4 1/2"		63 jts. 2650'

Describe in detail the manner in which the well was plugged, indicating where the mud fluid was placed and the method or methods used in introducing it into the hold. If cement or other plugs were used, state the character of same and depth placed, from \_\_\_\_\_ feet to \_\_\_\_\_ feet for each plug set.

C.I.B.P. @ 3570' K.B. set over Mississippian. Sand fill back from 3570-3435'  
with 12 sacks 20.40 sand. Dumped four (4) sacks common cement on top of sand.  
Displaced 15 sacks gel, 6 sacks cottonseed hulls, 10 sacks gel, 8 5/8"  
wooden plug, 125 sacks common cement with 3% CaCl<sub>2</sub>  
Operation completed at 3:00 P.M.  
Max. Pumping Pressure: 500 psig. ISIP: 200 psig.

(If additional description is necessary, use BACK of this sheet)

Name of Plugging Contractor Pratt Well Service, Inc. Box 847 Pratt, Kansas 67124

STATE OF KANSAS COUNTY OF RENO, ss.

A. L. Maas (employee of owner) or (owner or operator) of the  
above-described well, being first duly sworn on oath, says: That I have knowledge of the  
facts, statements, and matters herein contained and the log of the above-described well as  
filed and that the same are true and correct. So help me God.

(Signature) A. L. Maas  
Suite 300, 107 N. Market Wichita, Ks.  
(Address) 67202

SUBSCRIBED AND SWORN TO before me this 3rd day of March, 19 83

My Commission expires: March 16, 1983

Sharon I. Clark  
STATE NOTARY PUBLIC  
3-4-83

Notary Public.

MAR 4 1983

CONSERVATION DIVISION  
Wichita, Kansas

