


STATE OF KANSAS  
STATE CORPORATION COMMISSION

Give All Information Completely  
Make Required Affidavit  
Mail or Deliver Report to:  
Conservation Division  
State Corporation Commission  
311 No. Broadway  
Wichita, Kansas

WELL PLUGGING RECORD

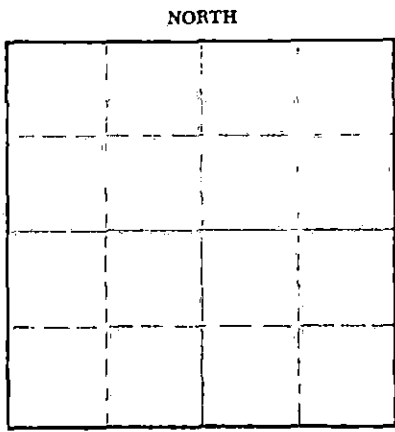

Locate well correctly on above  
Section Plat

Reno County, Sec. 20 Twp. 22 Rge. 8W (E) (W)  
Location as "NE/CNW&SW" or footage from lines C NW SE  
Lease Owner Mull Drilling Company  
Lease Name Bennett Well No. 1  
Office Address 670 Fourth Nat'l Bank Bldg. Wichita, Kansas  
Character of Well (completed as Oil, Gas or Dry Hole) Oil  
Date well completed 19  
Application for plugging filed May 6 1962  
Application for plugging approved May 6 1962  
Plugging commenced May 6 1962  
Plugging completed May 8 1962  
Reason for abandonment of well or producing formation dry

If a producing well is abandoned, date of last production 19  
Was permission obtained from the Conservation Division or its agents before plugging was commenced? Yes

Name of Conservation Agent who supervised plugging of this well Fred Hampel Pretty Prairie, Kansas  
Producing formation Depth to top Bottom Total Depth of Well 3622 Feet  
Show depth and thickness of all water, oil and gas formations.

OIL, GAS OR WATER RECORDS

CASING RECORD

FORMATION	CONTENT	FROM	TO	SIZE	PUT IN	PULLED OUT
				8 5/8	220	
				4 1/2		2931

Describe in detail the manner in which the well was plugged, indicating where the mud fluid was placed and the method or methods used in introducing it into the hole. If cement or other plugs were used, state the character of same and depth placed, from 3622 feet to 3603 feet for each plug set.

Cleaned out cellar. Worked pipe and measured T.D. Sanded well to 3580, dumped 4 sacks cement. Shot well @ 3000-2910. Worked pipe and started pipe. Pulled pipe. Plugged well, bailed hole and built rock bridge @ 210'. Dumped 2 sacks cement and 3 yards ready-mix.

*Recd 10-11-62*

(If additional description is necessary, use BACK of this sheet)

Name of Plugging Contractor Forbes Casing Pulling, Inc.  
Address Box 221 Great Bend, Kansas

STATE OF \_\_\_\_\_, COUNTY OF \_\_\_\_\_, ss.  
\_\_\_\_\_ (employee of owner) or (owner or operator) of the above-described well, being first duly sworn on oath, says: That I have knowledge of the facts, statements, and matters herein contained and the log of the above-described well as filed and that the same are true and correct. So help me God.

(Signature) *J. O. Forbes*  
(Address)

SUBSCRIBED AND SWORN TO before me this \_\_\_\_\_ day of \_\_\_\_\_, 19 \_\_\_\_\_

My commission expires \_\_\_\_\_

Notary Public.



ROTARY DRILLERS LOG

COMPANY: Mull Drilling Co., Inc., et al  
Wichita, Kansas

ROTARY DRILLING COMMENCED: 2/1/62

CONTRACTOR: Mull Drilling Co. Inc.  
Wichita, Kansas

ROTARY DRILLING COMPLETED: 2/10/62

CASING RECORD: 248' of 8 5/8" csg w/175 sz  
3565 of 4 1/2" csg w/125 sz  
(set csg., frac & plugged)  
D & A

LOCATION: BENNETT #1  
C NW SE 20-22S-8W  
Reno County, Kansas

(Figures indicate bottom of formation - measurements taken from top of Rotary Bushing)

600'	Red Bed
1010'	Shale & Shells
1400'	Shale w/lams
3605'	Lime & Shale
3622'	Kinderhook - total depth

I hereby certify that this is a true and correct copy of the above log to the best of my knowledge.

MULL DRILLING COMPANY, INC.

10-11-62  
**RECEIVED**  
STATE CORPORATION COMMISSION

*Delbert J. Costa*  
Delbert J. Costa, Geologist

OCT 11 1962

CONSERVATION DIVISION  
Wichita, Kansas

STATE OF KANSAS )  
                          ) SS  
COUNTY OF SEDGWICK )

Subscribed and sworn to before me this 20th day of February, 1962



*Madge N. Miller*  
Notary Public

Expires: 2/24/64