


STATE OF KANSAS
STATE CORPORATION COMMISSION

Give All Information Completely
Make Required Affidavit
Mail or Deliver Report to:
Conservation Division
State Corporation Commission
211 No. Broadway
Wichita, Kansas

WELL PLUGGING RECORD

Reno County, Sec. 28 Twp 22S Rge. (E) 8 (W)
Location as "NE/CNW/SW" or footage from lines C NE SE
Lease Owner Rains & Williamson Oil Co.
Lease Name CAREY Well No. 1
Office Address 1425 Wichita Plaza, Wichita, Kansas
Character of Well (completed as Oil, Gas or Dry Hole) Dry Hole
Date well completed February 26 1965
Application for plugging filed February 26 1965
Application for plugging approved February 26 1965
Plugging commenced February 26 1965
Plugging completed February 26 1965
Reason for abandonment of well or producing formation no oil or gas found
in commercial quantities.
If a producing well is abandoned, date of last production - - 19
Was permission obtained from the Conservation Division or its agents before plugging was commenced? Yes

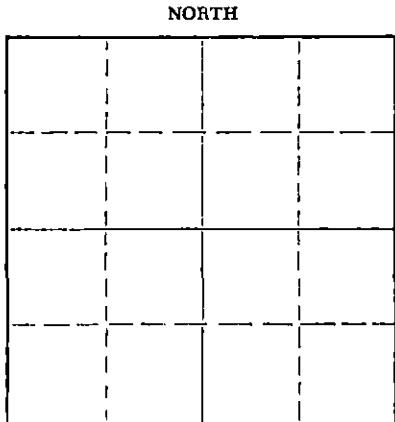

Locate well correctly on above
Section Plat

Name of Conservation Agent who supervised plugging of this well Gilbert Toman, Holyrood, Kansas
Producing formation _____ Depth to top _____ Bottom _____ Total Depth of Well 3680 Feet
Show depth and thickness of all water, oil and gas formations.

OIL, GAS OR WATER RECORDS

CASING RECORD

FORMATION	CONTENT	FROM	TO	SIZE	PUT IN	PULLED OUT
				8-5/8"	284.30'	None

Describe in detail the manner in which the well was plugged, indicating where the mud fluid was placed and the method or methods used in introducing it into the hole. If cement or other plugs were used, state the character of same and depth placed, from _____ feet to _____ feet for each plug set.

Set bridge at 270', cement thru drill pipe with 25 sacks cement, mud back to 40', set solid bridge, capped with 10 sacks cement. Plug down 11:20 p.m. 2-26-65.

RECEIVED
STATE CORPORATION COMMISSION
3-2-65
MAR 2 1965

CONSERVATION DIVISION
Wichita, Kansas

(If additional description is necessary, use BACK of this sheet)
Name of Plugging Contractor Rains & Williamson Oil Co.
Address 1425 Wichita Plaza, Wichita 2, Kansas

STATE OF KANSAS, COUNTY OF SEDGWICK, ss.
Wilson Rains (owner or operator) of the above-described well, being first duly sworn on oath, says: That I have knowledge of the facts, statements, and matters herein contained and the log of the above-described well as filed and that the same are true and correct. So help me God.
(Signature) Wilson Rains
1425 Wichita Plaza, Wichita, Kansas (Address)

SUBSCRIBED AND SWORN to before me this 1st day of March, 1965

My commission expires January 8, 1968

Shirley Keck
Shirley Keck Notary Public.

ROTARY DRILLING LOG

Operator: Rains & Williamson Oil Co. Contractor: Rains & Williamson
 #1 CAREY Oil Co.
 C NE SE Section 28-22S-8W Commenced: 2-18-65
 Reno County, Kansas Completed: 2-26-65

Remarks: Set 284.30' of 8-5/8"
 Surface Casing at 285'
 with 175 sacks GL 3
 cement.

FORMATIONS:

Soil & Clay	40'
Sand	120'
Red Bed	228'
Anhydrite	248'
Shale & Gyp	285'
Shale & Shells	1135'
Shale & Lime Streaks	1260'
Lime & Shale	2150'
Shale & Lime Streaks	2400'
Shale & Lime	2490'
Lime & Shale	3095'
Lime	3495'
Lime & Shert	3567'
Lime	3695'
Miss	
Rotary Total Depth (D&A)	3680'

RECEIVED
 STATE CORPORATION COMMISSION

MAR 2 1965
 3-2-65
 CONSERVATION DIVISION
 Wichita, Kansas

We certify the above log is true and
 correct to the best of our knowledge
 and belief.

RAINS & WILLIAMSON OIL CO.

Wilson Rains
 Wilson Rains, Partner

Subscribed and sworn to before me, a Notary Public in and for the State
 of Kansas, County of Sedgwick, this 1st day of March, 1965.

My Commission Expires:
 January 8, 1968

Shirley Keck
 Shirley Keck, Notary Public