

STATE OF KANSAS  
STATE CORPORATION COMMISSION


WELL PLUGGING RECORD

Give All Information Completely  
Make Required Affidavit  
Mail or Deliver Report to:  
Conservation Division  
State Corporation Commission  
800 Bittling Building  
Wichita, Kansas

Reno County, Sec. 7 Twp. 22S Rge. (E) 9 (W)

Location as "NE/CNWxSWx" or footage from lines SE NW NW  
Lease Owner Globe Oil & Gas Company  
Lease Name Drake "B" Well No. 1  
Office Address 301 South Market  
Character of Well (completed as Oil, Gas or Dry Hole) Dry Hole  
Date well completed July 28, 1954  
Application for plugging filed July 30, 1954  
Application for plugging approved (verbal 7-28-54) August 2, 1954  
Plugging commenced July 28, 1954  
Plugging completed July 28, 1954  
Reason for abandonment of well or producing formation Dry Hole

NORTH

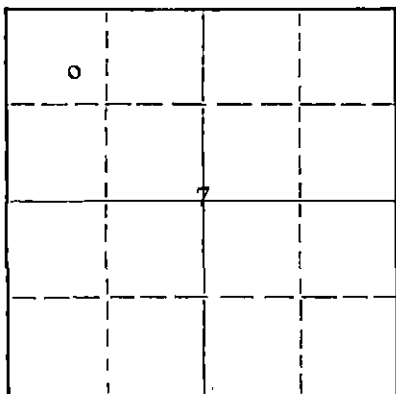

Locate well correctly on above  
Section Plat

If a producing well is abandoned, date of last production 19  
Was permission obtained from the Conservation Division or its agents before plugging was commenced? Yes

Name of Conservation Agent who supervised plugging of this well Ruel E. Durkee  
Producing formation Depth to top Bottom Total Depth of Well 3721 Feet  
Show depth and thickness of all water, oil and gas formations.

OIL, GAS OR WATER RECORDS

CASING RECORD

FORMATION	CONTENT	FROM	TO	SIZE	PUT IN	PULLED OUT
				8 5/8"	354' 9"	None

Describe in detail the manner in which the well was plugged, indicating where the mud fluid was placed and the method or methods used in introducing it into the hole. If cement or other plugs were used, state the character of same and depth placed, from feet to feet for each plug set.

Set bottom plug at 190' and cem. with 15 sacks. Mud to 25'.  
Set top plug at 25' and cem. with 5 sacks.

(If additional description is necessary, use BACK of this sheet)  
Name of Plugging Contractor Sterling Drilling Co.  
Address Sterling, Kansas

STATE OF KANSAS, COUNTY OF SEDGWICK, ss.  
Leo Ross (employee of owner) or (owner or operator) of the above-described well, being first duly sworn on oath, says: That I have knowledge of the facts, statements, and matters herein contained and the log of the above-described well as filed and that the same are true and correct. So help me God.

(Signature) [Signature]  
301 South Market, Wichita, Kansas (Address)

SUBSCRIBED AND SWORN TO before me this 3rd day of August, 1954

My commission expires July 21, 1958

[Signature] Notary Public.  
RECEIVED CORPORATION COMMISSION  
AUG 4 - 1954  
CONSERVATION DIVISION  
Wichita, Kansas

PLUGGING  
FILE SEC 7 T 22 R 9W  
BOOK PAGE 32 LINE 36

Globe Oil & Refining Co.  
 No. 1 Marilyn Drake "B"  
 SE NW NW Sec. 7-22S-9W  
 Reno County, Kansas

Drilling Commenced: 7-15-54  
 Drilling Completed: 7-28-54  
 Drilling Contractor: Sterling Drilling Co.  
 T.D. 3721'  
 Dry & Abandoned

Casing Record:

8 5/8" 354'9" Set @ 351'6"  
 Cem. w/ 250 sacks

<u>Formation</u>	<u>Depth</u>
Sand & red bed	342
Anhydrite	352
Red bed & shale	800
Shale & shells	1370
Shale & lime	1530
Lime	1665
Lime & shale	2680
Lime	2810
Lime & Shale	2895
Lime	2980
Shale & lime	3210
Lime	3430
Lime & shale	3495
Lime	3545
Chert & lime	3570
Chert	3600
Lime	3605
Shale & lime	3635
Sand & shale	3683
Lime Arbuckle	3721

Geological Tops:

	Elev.	D.F.	R.B.
Topeka	1748		1750
Heebner	2632		-882
Toronto	2932		-1182
Lansing-K.C.	2951		-1201
Conglomerate	3102		-1352
Viola	3472		-1722
Simpson Sh.	3523		-1773
Simpson Sd.	3616		-1866
Arbuckle Dolo.	3624		-1874
Rotary T.D.	3682		-1932
Sch. T.D.	3721		-1971
	3719		-1969

**PLUGGING**  
 FILE SEC 7 T 29 R 9W  
 BOX PAGE 52 LINE 36

7-31-54  
**RECEIVED**  
 STATE CORPORATION COMMISSION  
 JUL 31 1954  
 CONSERVATION DIVISION  
 Wichita, Kansas