


STATE OF KANSAS
STATE CORPORATION COMMISSION

Form CP-4

WELL PLUGGING RECORD

Give All Information Completely
Make Required Affidavit
Mail or Deliver Report to:
Conservation Division
State Corporation Commission
P. O. Box 17027
Wichita, Kansas 67217
NORTH

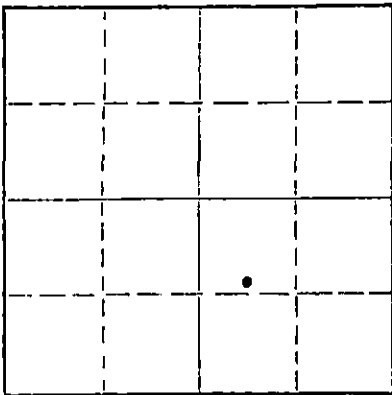

Locate well correctly on above
Section Flat

Kearny County, Sec. 31 Twp. 24S Rge. (E) 36 (W)
Location as "NE/CNWxSWx" or footage from lines 2000' FEL & 1500' FSL
Lease Owner Amoco Production Company SE SW NW SE
Lease Name Moser Gas Unit "A" Well No. 2
Office Address P. O. Box 432 - Liberal, Kansas 67901
Character of Well (completed as Oil, Gas or Dry Hole) Lost Hole
Date well completed _____ 19____
Application for plugging filed _____ 5-27- 19 76
Application for plugging approved _____ 5-28- 19 76
Plugging commenced _____ 6-9- 19 76
Plugging completed _____ 6-9- 19 76
Reason for abandonment of well or producing formation Lost Hole

If a producing well is abandoned, date of last production _____ 19____
Was permission obtained from the Conservation Division or its agents before plugging was commenced? Yes

Name of Conservation Agent who supervised plugging of this well Mr. Clarence Thomas
Producing formation None Depth to top _____ Bottom _____ Total Depth of Well 1280 Feet
Show depth and thickness of all water, oil and gas formations.

OIL, GAS OR WATER RECORDS

CASING RECORD

FORMATION	CONTENT	FROM	TO	SIZE	PUT IN	PULLED OUT
				8-5/8	591	None

Describe in detail the manner in which the well was plugged, indicating where the mud fluid was placed and the method or methods used in introducing it into the hole. If cement or other plugs were used, state the character of same and depth placed, from _____ feet to _____ feet for each plug set.
Filled well bore from 1280' to 3' with 400 sacks of cement. Cut casing off 3' below surface and welded on cap.

6-23-76

(If additional description is necessary, use BACK of this sheet)


Name of Plugging Contractor Halliburton
Address P. O. Drawer 1431 - Duncan, Oklahoma

STATE OF Kansas, COUNTY OF Seward, ss.
Gale McCord (employee of owner) or (~~owner or operator~~) of the above-described

well, being first duly sworn on oath, says: That I have knowledge of the facts, statements, and matters herein contained and the log of the above-described well as filed and that the same are true and correct. So help me God.

(Signature) Gale McCord Gale McCord
P. O. Box 432 - Liberal, Kansas 67901
(Address)

Subscribed AND Sworn to before me this 22nd day of June, 1976

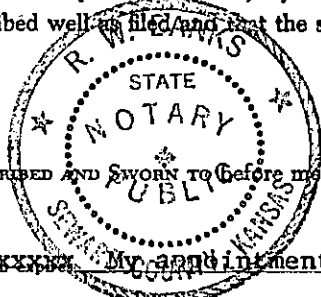

R. W. Banks
Notary Public.