


STATE OF KANSAS
STATE CORPORATION COMMISSION

WELL PLUGGING RECORD

Give All Information Completely
Make Required Affidavit
Mail or Deliver Report to
Conservation Division
State Corporation Comm.
245 North Water
Wichita, KS 67202

Kearny County. Sec. 16 Twp. 24 Rge. 36 E/W
Location as "NE/CNW $\frac{1}{2}$ SW $\frac{1}{2}$ " or footage from lines
1320 FMI & 1320 FWI
Lease Owner Kansas Nebraska Natural Gas Co. Inc.
Lease Name McDowell Well No. 1-2
Office Address Lakin, Kansas 67860
Character of Well (Completed as Oil, Gas or Dry Hole) _____

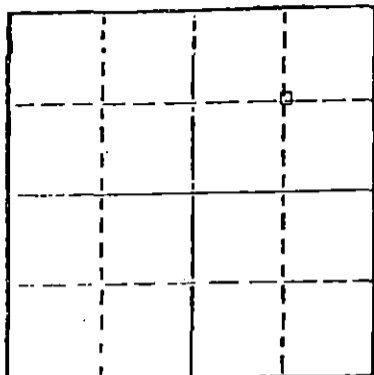

Locate well correctly on above Section Plot

Lost hole
Date Well completed 9-3 1977
Application for plugging filed 8-22 1977
Application for plugging approved 8-25 1977
Plugging commenced 9-3 1977
Plugging completed 9-3 1977

Reason for abandonment of well or producing formation
Lost hole
If a producing well is abandoned, date of last production
None 19

Was permission obtained from the Conservation Division or its agents before plugging was commenced? Yes

Name of Conservation Agent who supervised plugging of this well Mr. Thomas
Producing formation _____ Depth to top _____ Bottom _____ Total Depth of Well 1208'
Show depth and thickness of all water, oil and gas formations.

OIL, GAS OR WATER RECORDS

CASING RECORD

| FORMATION | CONTENT | FROM | TO | SIZE | PUT IN | PULLED OUT |
|------------|---------|------|----|--------|--------|------------|
| Surface | | | | 8 5/8" | 562' | 0' |
| Longstring | | | | 7" | 1208' | 0' |
| | | | | | | |
| | | | | | | |

Describe in detail the manner in which the well was plugged, indicating where the mud fluid was placed and the method or methods used in introducing it into the hold. If cement or other plugs were used, state the character of same and depth placed, from _____ feet to _____ feet for each plug set.

Put bridge & 25 sacks cement 510' to 400'
Mud 400' to 50'
Put bridge & 10 sacks cement 50' to 0'
Cut off 8 5/8" & 7" 3' below ground level.

RECEIVED
STATE CORPORATION COMMISSION
SEP 06 1977
9-8-77
CONSERVATION DIVISION
Wichita, Kansas

(If additional description is necessary, use BACK of this sheet)

Name of Plugging Contractor Midwest Casing Pulling
Box F, Sublette, Kansas 67877 Kans. Permit # 766

STATE OF KANSAS COUNTY OF Haskell, ss.
I Edgar J. Eves (employee of owner) or (owner or operator)
of the above-described well, being first duly sworn on oath, says: That I have knowledge of the facts, statements, and matters herein contained and the log of the above-described well as filed and that the same are true and correct. So help me God.

(Signature) Edgar J. Eves
Box F, Sublette, Kansas 67877
(Address)

SUBSCRIBED AND SWORN TO before me this 3 rd day of September, 19 77

J. M. Eves J. M. Eves
Notary Public.

My commission expires Sept. 8 1978

