


Give All Information Completely
Make Required Affidavit
Mail or Deliver Report to:
Conservation Division
State Corporation Commission
212 North Market, Insurance Bldg.
Wichita, Kansas

WELL PLUGGING RECORD

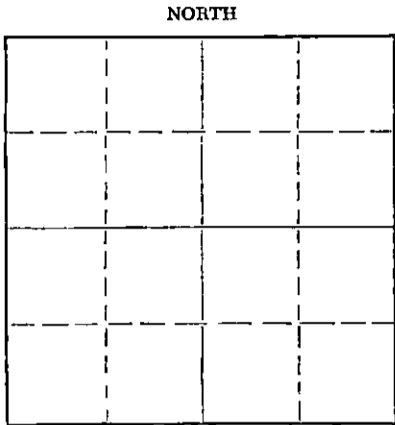

Locate well correctly on above Section Plat

Finney County. Sec. 32 Twp. 24S Rge. (E) 33 (W)
Location as "NE/CNW&SW" or footage from lines. C SW/4 SW/4
Lease Owner Greenland Drilling Company
Lease Name Spratt Well No. A-1
Office Address 4722 Broadway, Kansas City 12, Mo.
Character of Well (completed as Oil, Gas or Dry Hole) Dry Hole
Date well completed 8-20 1959
Application for plugging filed 8-20 1959
Application for plugging approved 8-20 1959
Plugging commenced 8-20 1959
Plugging completed 8-20 1959
Reason for abandonment of well or producing formation Dry Hole

If a producing well is abandoned, date of last production 19
Was permission obtained from the Conservation Division or its agents before plugging was commenced? Yes

Name of Conservation Agent who supervised plugging of this well _____
Producing formation _____ Depth to top _____ Bottom _____ Total Depth of Well 5163 Feet
Show depth and thickness of all water, oil and gas formations.

OIL, GAS OR WATER RECORDS

CASING RECORD

FORMATION	CONTENT	FROM	TO	SIZE	PUT IN	PULLED OUT
				8-5/8"	785'	None

Describe in detail the manner in which the well was plugged, indicating where the mud fluid was placed and the method or methods used in introducing it into the hole. If cement or other plugs were used, state the character of same and depth placed, from _____ feet to _____ feet for each plug set.

Plug and 120 sacks cement at 2800'
Plug and 20 sacks cement at 700'
Plug and 10 sacks cement at 35'

(If additional description is necessary, use BACK of this sheet)

Name of Plugging Contractor Greenland Drilling Company
Address 4722 Broadway, Kansas City 12, Mo.

STATE OF Kansas, COUNTY OF Sedgwick, ss.
Oscar Bridge (employee of owner) or (owner or operator) of the above-described well, being first duly sworn on oath, says: That I have knowledge of the facts, statements, and matters herein contained and the log of the above-described well as filed and that the same are true and correct. So help me God.

(Signature) Oscar Bridge
Oscar Bridge, Vice-President
4722 Broadway, Kansas City 12, Mo.
(Address)

SUBSCRIBED AND SWORN TO before me this 21th day of August, 19 59

Verdina B. Rutledge
Notary Public.

My commission expires March 15, 1960

PLUGGING
FILE SEC 321 24R 33W
BOOK PAGE 63 LINE 22

RECEIVED
STATE CORPORATION COMMISSION
AUG 27 1959 8-27-59
CONSERVATION DIVISION
Wichita

WELL LOG

Company: GREENLAND DRILLING COMPANY
Farm: SPRATT No. A-1

Sec. 32 Twp. 24S Rge. 33 W
Location: C SW/4 SW/4
Finney County, Kansas

Commenced: 7-29-59
Completed: 8-20-59
Total Depth: 5163'
Contractor: GREENLAND DRILLING COMPANY

Casing: 8-5/8" 785' w/500. sks. 2% cacl. Elevation: 2920 RB
5-1/2" -- Production: D & A

Figures Indicate Bottom of Formations

130	Sand	TOPS:	
250	Shale	Herrington	2536
460	Sand	Upper Kreider	2570
725	Shale	Lower Kreider	2600
785	Shale & shells	Winfield	2626
870	Shale	Upper Ft. Riley	2685
1335	Shale & Red bed.	Heebner	3883
1370	Anhydrite	Tobonto	3895
1450	Red Bed	Lansing	3974
1635	Red bed & sand	Marmaton	4419
1900	Shale & Red bed	Cherokee	4518
2430	Lime & shale	Morrow	4853
2490	Shale & lime	Mississippi	4972
2788	Lime & shale	St. Louis	5104
2820	Sand & shale	St. Louis Spargen	5140
2920	Lime & shale	RTD	5163
3021	Chalky lime & shale		
3405	Lime		
3495	Lime & shale	Drill Stem Test:	
4605	Lime	4675-4765	
4652	Lime & shale	Open 20 min. Closed 20 min.	
4720	Lime	Recovered 5' drilling mud	
4750	Shale & sand	115# IFP; 115# FFP; 779# BHP	
4765	Miss.		
4828	Lime & chert		
4870	Lime		
4909	Shale & lime		
4938	Shale & sand		
4987	Sand & lime		
5163	Lime		
5163	RTD		

RECEIVED
STATE CONSERVATION COMMISSION
AUG 27 1959 4-27-59
CONSERVATION DIVISION
Wichita, Kansas

STATE OF KANSAS, COUNTY OF SEDGWICK, ss:

I, Oscar Bridge, of the Greenland Drilling Company, upon oath state that the above and foregoing is a true and correct copy of the log of the #1-A Spratt well.

Oscar Bridge
Oscar Bridge, Vice-President

Subscribed and sworn to before me this 24th day of August, 1959.

Verdina B. Rutledge
Verdina B. Rutledge, Notary Public

My commission expires March 15, 1960.

PLUGGING
FILE SEC. 32 T. 24 R. 33W
BOOK PAGE 63 LINE 22