


WELL PLUGGING RECORD

Give All Information Completely  
Make Required Affidavit  
Mail or Deliver Report to:  
Conservation Division  
State Corporation Commission  
212 North Market, Insurance Bldg.  
Wichita, Kansas

Finney County, Sec. 31 Twp. 24 Rge. 33 (E) W (W)

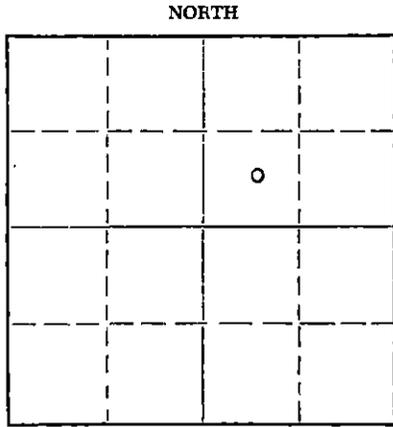

Locate well correctly on above Section Plat

Location as "NE/CNW/SW" or footage from lines C SW NE  
Lease Owner Kansas Natural Gas Inc.  
Lease Name Spatt Well No. 1  
Office Address Box 599 Hays, Kansas  
Character of Well (completed as Oil, Gas or Dry Hole) Gas  
Date well completed 1960 19  
Application for plugging filed January 18 19 60  
Application for plugging approved January 18 19 60  
Plugging commenced April 18 19 60  
Plugging completed April 18 19 60  
Reason for abandonment of well or producing formation Replaced for mechanical difficulties in operation  
If a producing well is abandoned, date of last production January 19 60  
Was permission obtained from the Conservation Division or its agents before plugging was commenced? Yes

Name of Conservation Agent who supervised plugging of this well Mr. Frank Broadfoot  
Producing formation Hugoton Depth to top 2525' Bottom 2800' Total Depth of Well 2800' Feet  
Show depth and thickness of all water, oil and gas formations.

OIL, GAS OR WATER RECORDS

CASING RECORD

FORMATION	CONTENT	FROM	TO	SIZE	PUT IN	PULLED OUT
Note: We have no available records on tops or formation thickness.						
				10 3/4"	500'	None
				7"	2550'	None
				5" liner	250'	None

Describe in detail the manner in which the well was plugged, indicating where the mud fluid was placed and the method or methods used in introducing it into the hole. If cement or other plugs were used, state the character of same and depth placed, from \_\_\_\_\_ feet to \_\_\_\_\_ feet for each plug set.

125 sacks common cement from 2800' to 2550'  
Mixed 20 sacks Aquagel Mud from 2550' to 450' dumped one sack hulls  
Mixed 200 sacks Common cement filled to top of cellar.

4-26-60  
RECEIVED  
STATE CORPORATION COMMISSION  
APR 26 1960  
CONSERVATION DIVISION  
Wichita, Kansas

(If additional description is necessary, use BACK of this sheet)

Name of Plugging Contractor Sun Cementing Company  
Address Liberal, Kansas

STATE OF Kansas COUNTY OF Finney ss.  
(employee of owner) or (owner or operator) of the above-described well, being first duly sworn on oath, says: That I have knowledge of the facts, statements, and matters herein contained and the log of the above-described well as filed and that the same are true and correct. So help me God.

(Signature) Laesh W. Shinkle, Supt.  
Box 455, Garden City, Kansas  
(Address)

SUBSCRIBED AND SWORN TO before me this 19th day of April 1960

My commission expires Oct. 24, 1963  
May Hope Notary Public.

