

15-055-10027-0001

STATE OF KANSAS
STATE CORPORATION COMMISSION

Form CP-4

Give All Information Completely
Make Required Affidavit
Mail or Deliver Report to:
Conservation Division
State Corporation Commission
212 No. Market
Wichita, Kansas 67202

WELL PLUGGING RECORD

Finney County, Sec. 27 Twp. 24S Rge. 33 (E) (W)

Location as "NE/CNW/SW" or footage from lines C SE NE

Lease Owner Cities Service Oil Co.

Lease Name Tait "C" Well No. 4

Office Address Box 1098, Liberal, Kans. 67901

Character of Well (completed as Oil, Gas or Dry Hole) Oil

Date well completed 1-6-62 19 62

Application for plugging filed 11-29 19 71

Application for plugging approved 11-30 19 71


Plugging commenced 12-22 19 71

Plugging completed 12-24 19 71

Reason for abandonment of well or producing formation Dry (Input well)

If a producing well is abandoned, date of last production 19

Was permission obtained from the Conservation Division or its agents before plugging was commenced? Yes

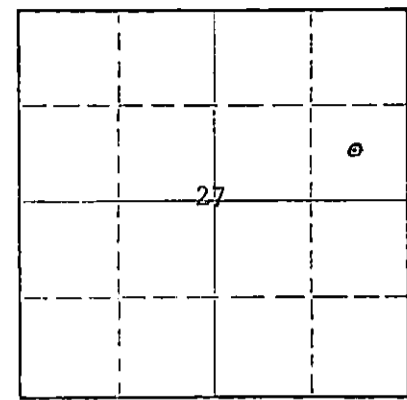

Locate well correctly on above Section Plat

Name of Conservation Agent who supervised plugging of this well E. Eves

Producing formation Morrow Depth to top 4774 Bottom 4788 Total Depth of Well 5041 Feet PB 4815

Show depth and thickness of all water, oil and gas formations.

OIL, GAS OR WATER RECORDS

CASING RECORD

FORMATION	CONTENT	FROM	TO	SIZE	PUT IN	PULLED OUT
Morrow	Oil	4784	4796	8-5/8	1922	0
				4-1/2	4920	1270

Describe in detail the manner in which the well was plugged, indicating where the mud fluid was placed and the method or methods used in introducing it into the hole. If cement or other plugs were used, state the character of same and depth placed, from _____ feet to _____ feet for each plug set.

25 sx cement	4815' - 4430'
Heavy mud	4430' - 1270'
35 sx cement	1270' - 1170'
Heavy mud	1170' - 40'
15 sx cement	40' - 4'

12-28-71

RECEIVED
STATE CORPORATION COMMISSION
DEC 28 1971
CONSERVATION DIVISION
Wichita, Kansas

(If additional description is necessary, use BACK of this sheet)

Name of Plugging Contractor Sargent Casing Pulling Service

Address Box 506, Liberal, Kansas 67901

STATE OF KANSAS, COUNTY OF SEWARD, ss.

C. A. Nenny (employee of owner) or (owner or operator) of the above-described

well, being first duly sworn on oath, says: That I have knowledge of the facts, statements, and matters herein contained and the log of the above-described well as filed and that the same are true and correct. So help me God.

(Signature) C. A. Nenny

Box 1098, Liberal, Kansas 67901

(Address)

SUBSCRIBED AND SWORN TO before me this 27th day of December, 19 71

B. J. McGriff

B. J. McGriff
Notary Public.

My commission expires 8-6-74

15-055-10027-0001

ROTARY DRILLING LOG

LEASE:	Tait "C" #4	CASING:	8-5/8" set @ 1922'
OWNER:	Cities Service Oil Co.		4-1/2" set @ 4920'
CONTRACTOR:	Holm Drilling Co.	COMMENCE:	12-3-61
LOCATION:	C SE NE, Sec. 27-24S-33W Finney Co., Kansas	COMPLETE:	1-6-62

Sand & Clay	0'- 400'
Shale	400'- 860'
Gyp & Shale	860'-1250'
Shale & Shells	1250'-1885'
Shale & Anhydrite	1885'-1924'
Shale	1924'-2185'
Red Bed & Shale	2185'-2400'
Shale & Lime	2400'-2590'
Shale & Shells	2590'-2730'
Lime & Shale	2730'-2875'
Lime	2875'-3486'
Shale & Lime	3486'-3578'
Lime & Shale	3578'-4675'
Lime	4675'-4738'
Lime & Shale	4738'-4772'
Sand, Lime, Shale	4772'-4805'
Lime & Shale	4805'-4889'
Lime	4889'-5041'
Rotary Total Depth	5041'

RECEIVED
STATE CORPORATION COMMISSION
NOV 30 1971
CONSERVATION DIVISION
Wichita, Kansas

We certify that the above log is true and correct to the best of our knowledge and belief.

CITIES SERVICE OIL COMPANY

By C. A. Nennery
C. A. Nennery
District Engineer