

STATE OF KANSAS
STATE CORPORATION COMMISSION
CONSERVATION DIVISION
P. O. BOX 17027
WICHITA, KANSAS 67217

FORM CP-4

WELL PLUGGING RECORD

Reno County, Sec. 6 Twp 22 Rge 4 (E) X (W)

Location as "NE/CNW/SE/SW" or footage from lines SE NE SW

Lease Owner A. Scott Ritchie

Lease Name GAEDDERT Well No. 1

Office Address 412 Union Center Building, Wichita, Kansas 67202

Character of Well (completed as Oil, Gas or Dry Hole) Dry Hole

Date well completed October 29 19 75

Application for plugging filed October 29 19 75

Application for plugging approved October 29 19 75


Plugging commenced October 29 19 75

Plugging completed October 29 19 75

Reason for abandonment of well or producing formation Dry Hole

If a producing well is abandoned, date of last production 19

Was permission obtained from the Conservation Division or its agents before plugging was commenced? yes

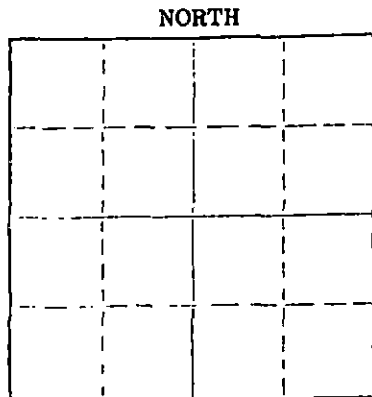

Locate well correctly on above Section Plot

Name of Conservation Agent who supervised plugging of this well Gilbert Toman

Producing formation Depth to top Bottom Total Depth of Well 3940

Show depth and thickness of all water, oil and gas formations.

OIL, GAS OR WATER RECORDS

CASING RECORD

FORMATION	CONTENT	FROM	TO	SIZE	PUT IN	PULLED OUT

Describe in detail the manner in which the well was plugged, indicating where the mud fluid was placed and the method or methods used in introducing it into the hole. If cement or other plugs were used, state the character of same and depth placed, from feet to feet for each plug set.

Hole full of heavy mud. Plug @ 450' w/40 sacks cement thru drill pipe.
Middle plug @ 240' w/25 sacks cement thru drill pipe.
Mud to 40' w/1/2 sack hulls plug & 10 sacks cement. 2 sacks in rat hole.

Name of Plugging Contractor Duke Drilling Co.
Address Box 823, Great Bend, Kansas 67530

STATE OF KANSAS, COUNTY OF BARTON ss.
Larry Curtis (employee of owner) or (owner) of the above-described

well, being first duly sworn on oath, says: That I have knowledge of the facts, statements, and matters herein contained and the log of the above-described well as filed and that the same are true and correct. So help me God.

(Signature) Larry Curtis
Box 823, Great Bend, Kansas 67530 (Address)

Subscribed and sworn to before me this 30th day of October, 1975

My commission expires April 11, 1978
Dorothy M. Haque Notary Public.

RECEIVED
STATE CORPORATION COMMISSION
NOV 3 1975 11-3-75
CONSERVATION DIVISION
Wichita, Kansas

DRILLERS' WELL LOG

DATE COMMENCED: October 21, 1975
DATE COMPLETED: October 29, 1975

A. Scott Ritchie
GANNETT # 1
SE NE SW of Sec 6-T22-R4W
Reno County, Kansas

ELEVATION: 1532 K.S.

0 - 249'	Red Bed, Sand Streaks
249 - 275'	Shale
275 - 2154'	Shale and Lime
2154 - 2478'	Lime
2478 - 2482'	Shale
2482 - 2498'	Shale and Lime
2498 - 2507'	Lime
2507 - 2716'	Shale
2716 - 3106'	Lime
3106 - 3257'	Lime and Shale
3257 - 3392'	Sand
3392 - 3638'	Lime
3638 - 3758'	Shale
3758 - 3940'	Sand
3940'	RTD

FORMATION TOPS

Topoka	2154
Heebner	2478
Toronto	2498
Douglas	2507
Lansing	2716
Base K.C.	3106
Cherokee	3257
Mississippi	3392
Kinderhook	3638
Hunton	3758
Simspon Sand	3926
RTD	3940'

SURFACE PIPE: Set 248' of
8 5/8", 20# used pipe w/175
sacks cement, 2% Gal, 3% cc.

A F F I D A V I T

STATE OF KANSAS }
COUNTY OF BARTON } ss.

Larry Curtis, of lawful age, does swear and state that the facts and statements herein contained are true and correct to the best of his knowledge.

Larry Curtis

Subscribed and sworn to before me this 31st day of October, 1975.

Dorothy M. Hague
Notary Public

My Commission Expires: April 11, 1978

11-3-75

RECEIVED
STATE OF KANSAS COMMISSION
NOV 3 1975
CONSERVATION DIVISION
Wichita, Kansas