


Give All Information Completely
Make Required Affidavit
Mail or Deliver Report to:
Conservation Division
State Corporation Commission
211 No. Broadway
Wichita, Kansas

NORTH

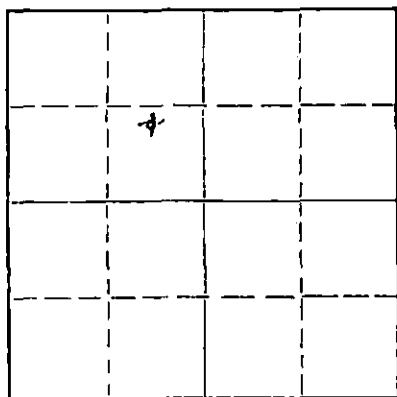

Locate well correctly on above
Section Plat

Harvey County, Sec. 7 Twp. 24S Rge. (E) 2W (W)
Location as "NE/CNW/SW" or footage from lines CNL SE/4 NW/4
Lease Owner Birmingham-Bartlett Drilling Co.
Lease Name Wear Well No. 3
Office Address 300 Kaufman Building, Wichita 2, Kansas
Character of Well (completed as Oil, Gas or Dry Hole) Dry Hole
Date well completed November 18, 1957
Application for plugging filed (Verbally approved) November 20, 1957
Application for plugging approved (Verbally approved) November 18, 1957
Plugging commenced November 18, 1957
Plugging completed November 18, 1957
Reason for abandonment of well or producing formation

If a producing well is abandoned, date of last production 19
Was permission obtained from the Conservation Division or its agents before plugging was commenced? Yes

Name of Conservation Agent who supervised plugging of this well Ruel Durkee
Producing formation Depth to top Bottom Total Depth of Well 3906 Feet
Show depth and thickness of all water, oil and gas formations.

OIL, GAS OR WATER RECORDS

CASING RECORD

FORMATION	CONTENT	FROM	TO	SIZE	PUT IN	PULLED OUT
		0	477	8-5/8"	477'	None

Describe in detail the manner in which the well was plugged, indicating where the mud fluid was placed and the method or methods used in introducing it into the hole. If cement or other plugs were used, state the character of same and depth placed, from feet to feet for each plug set.

Plugged hole: 15 sacks cement mixed and poured through drill pipe on bottom plug set at 300'. 5 sacks mixed and poured on top plug set 20' below bottom of cellar. (Ordered by State Plugger, Ruel Durkee.)

11-21-57

RECEIVED
STATE CORPORATION COMMISSION

NOV 21 1957

CONSERVATION DIVISION
Wichita, Kansas

(If additional description is necessary, use BACK of this sheet)
Name of Plugging Contractor Birmingham-Bartlett Drilling Co.
Address 300 Kaufman Bldg., Wichita 2, Kansas

STATE OF KANSAS, COUNTY OF SEDGWICK ss.
Richard Hindery, partner of Birmingham-Bartlett Drilling Co. owner & operator
well, being first duly sworn on oath, says: That I have knowledge of the facts, statements, and matters herein contained and the log of the above-described well as filed and that the same are true and correct. So help me God. BIRMINGHAM-BARTLETT DRILLING CO.

(Signature) By Richard Hindery
Partner
300 Kaufman Bldg., Wichita 2, Kansas
(Address)

SUBSCRIBED AND SWORN TO before me this 20th day of November, 1957.

My commission expires November 29, 1958. Vivian F. Yinger, Notary Public.

PLUGGING
FILE SEC 7 T 24 R 26
BOOK PAGE 62 LINE 18

WELL #3 HILL

LOCATION: OIL 2 1/4 W 1/4 Sec. 7-248-3W
Harvey County, Kansas

STUDIED: 11-4-57

COMPLETED: 11-18-57

OWNER, OPERATOR
and CONTRACTOR: Birmingham-Bartlett Drilling Co.
300 Kaufman Building
Wichita 2, Kansas

SERVICE CASING: 8-5/8" casing cemented at 477'
with 375 sacks cement & 0 c.c.

OIL SPRING: None set. D & A

LOG

(Figures indicate bottom of formation)

0 - 255	Sand & Shale
457	Shale
505	Anhydrite
2770	Lime & Shale
3215	Lime
3300	Lime & Shale
3525	Lime
3550	Lime & Chert
3620	Cherty Lime
3677	Lime
3703	Lime & Shale
3706	Lime
3706	Rotary Total Depth - D & A

The undersigned, Richard Hindery, one of the partners of Birmingham-Bartlett Drilling Co., hereby certifies that the above is a true and correct log of the formations encountered in drilling the W 1/4 Sec. 7-248-3W, as shown in the daily drilling reports.

BIRMINGHAM-BARTLETT DRILLING CO.

By Richard Hindery

Subscribed and sworn to before me
this 20th day of November, 1957.

Vivian F. Yinger
Vivian F. Yinger, Notary Public

My commission expires November 29, 1958.

11-21-57

