


STATE OF KANSAS
 STATE CORPORATION COMMISSION
 Give All Information Completely
 Make Required Affidavit
 Mail or Deliver Report to:
 Conservation Division
 State Corporation Commission
 211 No. Broadway
 Wichita, Kansas

15-079-0014-0000

WELL PLUGGING RECORD

Harvey County, Sec. 7 Twp. 24S Rge. 2 (E) W (W)
 Location as "NE/CNWxSWx" or footage from lines SW/4 SW/4 NW/4
 Lease Owner Birmingham-Bartlett Drilling Co.
 Lease Name Wear Well No. 2
 Office Address 300 Kaufman Bldg., Wichita 2, Kansas
 Character of Well (completed as Oil, Gas or Dry Hole) Dry Hole
 Date well completed May 8, 19 57
 Application for plugging filed (verbal) May 8, 19 57
 Application for plugging approved (verbal) May 8, 19 57
 Plugging commenced May 8, 19 57
 Plugging completed May 8, 19 57
 Reason for abandonment of well or producing formation Dry Hole

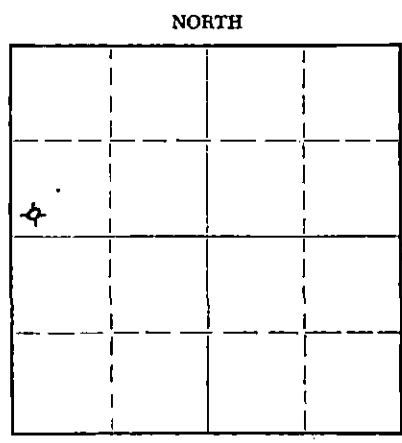

Locate well correctly on above Section Plat

If a producing well is abandoned, date of last production 19
 Was permission obtained from the Conservation Division or its agents before plugging was commenced? Yes
 Name of Conservation Agent who supervised plugging of this well Ruel Durkee
 Producing formation _____ Depth to top _____ Bottom _____ Total Depth of Well 3918 Feet
 Show depth and thickness of all water, oil and gas formations.

OIL, GAS OR WATER RECORDS				CASING RECORD		
FORMATION	CONTENT	FROM	TO	SIZE	PUT IN	PULLED OUT
		0	487'	8-5/8"	487'	none

Describe in detail the manner in which the well was plugged, indicating where the mud fluid was placed and the method or methods used in introducing it into the hole. If cement or other plugs were used, state the character of same and depth placed, from _____ feet to _____ feet for each plug set.

Plugged hole. Bottom plug set at 470 feet with 20 sacks cement mixed and poured through drill pipe. Top plug set at 15 feet below ground level with 5 sacks cement mixed and poured through drill pipe.

RECEIVED
 STATE CORPORATION COMMISSION 5-11-57
 MAY 11 1957
 CONSERVATION DIVISION

(If additional description is necessary, use BACK of this sheet)
 Name of Plugging Contractor Birmingham-Bartlett Drilling Co.
 Address 300 Kaufman Bldg., Wichita 2, Kansas

STATE OF Kansas, COUNTY OF Sedgwick
 Richard Hindery, partner of Birmingham-Bartlett Drilling Co., owner and contractor (employee of owner or partner or operator) of the above-described well, being first duly sworn on oath, says: That I have knowledge of the facts, statements, and matters herein contained and the log of the above-described well as filed and that the same are true and correct. So help me God. BIRMINGHAM-BARTLETT DRILLING CO.
 (Signature) By Richard Hindery Partner
 300 Kaufman Bldg., Wichita 2, Kansas (Address)

SUBSCRIBED AND SWORN TO before me this 10th day of May, 19 57.

 My commission expires October 2, 1958. Beverly Larson
Notary Public.

PLUGGING
 FILE SEC 7 T. 24 R. 2W
 BOOK PAGE 12 LINE 9

WEAR NO. 2 WELL

LOCATION: SW/4 SW/4 NW/4
 Section 7-24S-2W
 Harvey County, Kansas

SPUDDED: 4-24-57
 COMPLETED: 5-8-57

OWNER, OPERATOR
 and CONTRACTOR: Birmingham-Bartlett Drilling Co.
 300 Kaufman Building
 Wichita 2, Kansas

SURFACE CASING: 8-5/8" 24# casing cemented at
 487' with 350 sacks cement and
 5 c.c.

OIL STRING: None set. Dry and abandoned.

L O G

(Figures indicate bottom of formation)

0	25	Clay
	260	Sand
	481	Shale and sand
	510	Anhydrite
	850	Shale and lime
	1150	Lime
	2530	Lime and shale
	3045	Lime
	3359	Shale and lime
	3400	Mississippi
	3430	Lime and chert
	3463	Lime
	3550	Shale, lime and chert
	3590	Cherty lime
	3620	Lime
	3685	Lime and chert
	3710	Lime
	3742	Lime, shale and chert
	3770	Lime
	3795	Shale and lime
	3798	Hunton lime
	3916	Lime and shale
	3918	Lime
	3918	Rotary Total Depth

5-11-57

RECEIVED
 STATE COMMISSION

MAY 11 1957

CONSERVATION DIVISION

The undersigned, Richard Hindery, one of the partners of Birmingham-Bartlett Drilling Co., hereby certifies that the above is a true and correct log of the formations encountered in drilling the Wear No. 2 Well as shown in the daily drilling reports.

BIRMINGHAM-BARTLETT DRILLING CO.

By Richard Hindery

Subscribed and sworn to before me
 this 10th day of May, 1957.

Beverly Larson
 Notary Public

My commission expires October 2, 1958.

PLUGGING
 FILE SEC 7-T 24 R 2W
 BOOK PAGE 12 LINE 9