


WELL PLUGGING RECORD

Give All Information Completely  
Make Required Affidavit  
Mail or Deliver Report to:  
Conservation Division  
State Corporation Commission  
800 Bitting Building  
Wichita, Kansas

Harvey County, Sec. 7 Twp. 24S Rge. (E) 2 (W)

Location as "NE/CNW/SW" or footage from lines SE 1 SW 1 NW 1  
Lease Owner Birmingham-Bartlett Drilling Co.  
Lease Name Wear Well No. 1  
Office Address 300 Kaufman Building, Wichita 2, Kansas  
Character of Well (completed as Oil, Gas or Dry Hole) Dry Hole  
Date well completed June 19 19 55  
Application for plugging filed verbally approved June 19 19 55  
Application for plugging approved verbally approved June 19 19 55  
Plugging commenced June 19 19 55  
Plugging completed June 19 19 55  
Reason for abandonment of well or producing formation Dry Hole

NORTH

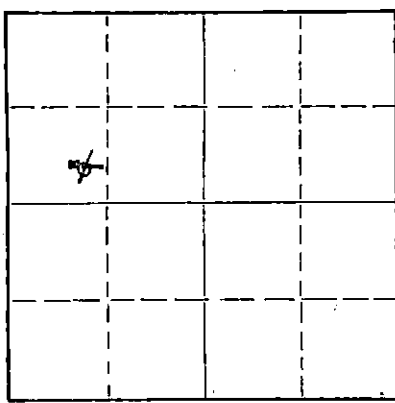

Locate well correctly on above Section Plat

If a producing well is abandoned, date of last production 19  
Was permission obtained from the Conservation Division or its agents before plugging was commenced? Yes

Name of Conservation Agent who supervised plugging of this well Ruel Durkee  
Producing formation Arbuckle Depth to top 3978 Bottom 4000' Total Depth of Well 4000' Feet  
Show depth and thickness of all water, oil and gas formations.

OIL, GAS OR WATER RECORDS CASING RECORD

FORMATION	CONTENT	FROM	TO	SIZE	PUT IN	PULLED OUT
		0	489'	8-5/8"	496.46'	None

Describe in detail the manner in which the well was plugged, indicating where the mud fluid was placed and the method or methods used in introducing it into the hole. If cement or other plugs were used, state the character of same and depth placed, from \_\_\_\_\_ feet to \_\_\_\_\_ feet for each plug set.

Set Bottom Plug at 350'. Put 16 sacks mixed cement through Drill Pipe on top of Plug. Mud up to 40'. Then filled 8-5/8" surface casing from 40' up to Base of Cellar with 14 sacks cement.

(If additional description is necessary, use BACK of this sheet)

Name of Plugging Contractor Birmingham-Bartlett Drilling Co.  
Address 300 Kaufman Bldg., Wichita 2, Kansas

STATE OF KANSAS COUNTY OF SEDGWICK  
E. L. Birmingham, Jr., partner of Birmingham-Bartlett Drilling Co. (owner or operator) of the above-described well, being first duly sworn on oath, says: That I have knowledge of the facts, statements, and matters herein contained and the log of the above-described well as filed and that the same are true and correct. So help me God. BIRMINGHAM-BARTLETT DRILLING CO.

(Signature) E. L. Birmingham, Jr. By E. L. Birmingham, Jr. Partner  
300 Kaufman Building, Wichita, 2, Kansas (Address)

I SUBSCRIBED AND SWORN to before me this 21st day of June, 19 55.

My commission expires November 29, 1958

Vivian F. Yinger  
Vivian F. Yinger, Notary Public.  
STATE OF KANSAS



PLUGGING CONSERVATION DIVISION  
Wichita, Kansas  
7 24 2w  
129 LINE 9  
6-23-55  
JUN 23 1955

WEAR NO. 1 WELL

LOCATION: SE $\frac{1}{4}$  SW $\frac{1}{4}$  NW $\frac{1}{4}$  Sec. 7-24S-2W  
Harvey County, Kansas

SPUDED: 6-4-55

COMPLETED: 6-19-55

OWNER, OPERATOR  
and CONTRACTOR: Birmingham-Bartlett Drilling Co.  
300 Kaufman Building  
Wichita 2, Kansas

SURFACE CASING: 8-5/8" surface casing cemented  
at 489' with 350 sacks cement and 3 c.c.

OIL STRING: None Run - Dry, Abandoned and Plugged.

L O G

(Figures indicate bottom of formation)

0 -	50	Clay and Sand
	110	Water Sand
	160	Shale
	250	Sand
	430	Shale and Shells
	482	Shale and Sand
	510	Anhydrite
	900	Lime and Shale
	1020	Sandy Lime
	1085	Shale and Shells
	1335	Shale and Lime
	1520	Shale and Shells
	1580	Sand
	2390	Lime and Shale
	2520	Shale
	2785	Lime
	2860	Lime and Shale
	3005	Lime
	3370	Lime and Shale
	3400	Lime
	3525	Cherty Lime
	3680	Lime
	3710	Lime and Shale
	3740	Lime
	3790	Lime and Shale
	3795	Lime
	3880	Shale
	3895	Lime
	3963	Lime and Sand
	4000	Lime and Shale
	4000'	Rotary Total Depth - D & A

The undersigned, E. L. Birmingham, Jr., one of the partners of Birmingham-Bartlett Drilling Co., hereby certifies that the above is a true and correct log of the formations encountered in drilling the Wear No. 1 Well, as shown in the daily drilling reports.

BIRMINGHAM-BARTLETT DRILLING CO.

By

*E. L. Birmingham Jr.*

Subscribed and sworn to before me this 21st day of June, 1955.

6-23-55

RECEIVED  
STATE CORPORATION COMMISSION

*Wesley L. Younger*  
Notary Public

My commission expires November 29, 1958.

PLUGGING DIVISION  
SEC 7-24S-2W  
PAGE 129 LINE 9