


STATE OF KANSAS
STATE CORPORATION COMMISSION

Give All Information Completely
Make Required Affidavit
Mail or Deliver Report to:
Conservation Division
State Corporation Commission
211 No. Broadway
Wichita, Kansas

15-079-00110-0000
WELL PLUGGING RECORD

NORTH

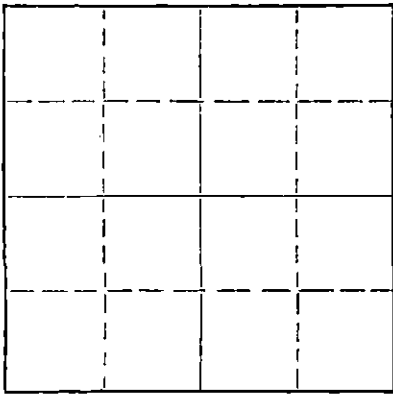

Locate well correctly on above
Section Plat

Harvey County. Sec. 18 Twp. 24 Rge. 3 (NW NE) (W)
Location as "NE/CNW/SW" or footage from lines _____
Lease Owner T.L. Ferrier
Lease Name Devenpeck #1 Well No. _____
Office Address Wichita, Kansas
Character of Well (completed as Oil, Gas or Dry Hole) _____
Date well completed _____ 19____
Application for plugging filed _____ 19____
Application for plugging approved _____ 19____
Plugging commenced 10-21-57 19____
Plugging completed 10-26-57 19____
Reason for abandonment of well or producing formation _____

If a producing well is abandoned, date of last production _____ 19____
Was permission obtained from the Conservation Division or its agents before plugging was commenced? yes

Name of Conservation Agent who supervised plugging of this well Ruel Durkee
Producing formation _____ Depth to top _____ Bottom _____ Total Depth of Well 3960 Feet
Show depth and thickness of all water, oil and gas formations.

OIL, GAS OR WATER RECORDS

CASING RECORD

FORMATION	CONTENT	FROM	TO	SIZE	PUT IN	PULLED OUT
				13"	194'	none
				8"	528'	none
				5 1/2"	3960'	3326'

Describe in detail the manner in which the well was plugged, indicating where the mud fluid was placed and the method or methods used in introducing it into the hole. If cement or other plugs were used, state the character of same and depth placed, from _____ feet to _____ feet for each plug set.

Checked the hole to 3960' and found it open.
Filled w/sand to 3905' and ran 5 sacks of cement.
Pulled 5 1/2" casing. Filled hoel with mud to 360'
set a 10' rock bridge and ran 15 sacks of cement.
Mudded the hole to 40', set a 10' rock bridge
and ran 10 sacks of cement to base of cellar.

STATE CORPORATION COMMISSION
NOV 30 1957
CONSERVATION DIVISION
11-30-57

(If additional description is necessary, use BACK of this sheet)
Name of Plugging Contractor West Supply Co., Inc.
Address Chase, Kansas

STATE OF _____, COUNTY OF _____, ss.
_____(employee of owner) or (owner or operator) of the above-described well, being first duly sworn on oath, says: That I have knowledge of the facts, statements, and matters herein contained and the log of the above-described well as filed and that the same are true and correct. So help me God.

(Signature) T.L. Ferrier

SUBSCRIBED AND SWORN TO before me this 29 day of November, 1957

(Address) William W. Bennett
Notary Public.

My commission expires 27 July 1960

PLUGGING
FILE SEC. 18 T. 24 R. 3E
BOOK PAGE 52 LINE 20

Co → T. L. Ferris
Contr. Garvey Oil Co

#1 Devenpeck
C NW/4 NW/4 NE/4
Section 18-24S-3W
Harvey County, Kansas

Drillers Log

Sand	0 to	150	Lime	3030
Shale		413	Lime & Shale	3133
Sand		421	Shale & Lime	3220
Shale		427	Lime & Shale	3360
Sand	0 to	150	Shale & Chert	3503
Shale		495	Chert	3547
Lime		550	Chert & Shale	3609
Shale & Salt		595	Shale & Chert	3646
Anhydrite		645	Chert & Shale	3730
Shale & Lime		848	Shale	3780
Lime & Shale		1440	Shale & Lime	3890
Shale		2204	Shale	3912
Shale & Lime		2705	Shale & Lime	2931
Lime & Shale		2900	Shale	3960 T.D.

10-10-57

RECEIVED
OCT 10 1957
CONSULTING DIVISION

PLUGGING
FILE SEC. 18 T. 24 S. 3
BOOK, PAGE 52 LIP 20