


STATE OF KANSAS
STATE CORPORATION COMMISSION
Give All Information Completely
Make Required Affidavit
Mail or Deliver Report to:
Conservation Division
State Corporation Commission
211 No. Broadway
Wichita, Kansas

NORTH

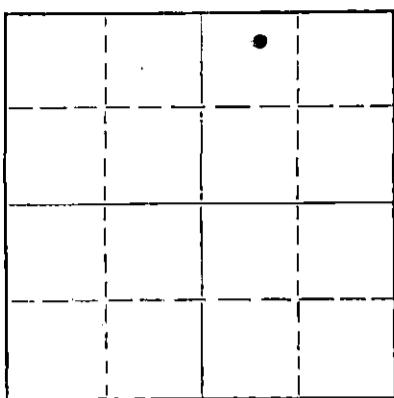

Locate well correctly on above
Section Plat

Name of Conservation Agent who supervised plugging of this well Gilbert J. Toman, Holyrood, Kansas

Producing formation _____ Depth to top _____ Bottom _____ Total Depth of Well 3945 Feet

Show depth and thickness of all water, oil and gas formations.

OIL, GAS OR WATER RECORDS

FORMATION	CONTENT	FROM	TO	SIZE	PUT IN	PULLED OUT

Describe in detail the manner in which the well was plugged, indicating where the mud fluid was placed and the method or methods used in introducing it into the hole. If cement or other plugs were used, state the character of same and depth placed, from 3945 feet to 500 feet for each plug set.

20 sks cement @ 500', 20 sks @ 200', 10 sks @ 40', 2 sks in rat hole.

RECEIVED
STATE CORPORATION COMMISSION

MAY 25 1965 5-25-1965

CONSERVATION DIVISION
Wichita, Kansas

(If additional description is necessary, use BACK of this sheet)

Name of Plugging Contractor German Drilling Company
Address 502 Petroleum Building, Wichita, Kansas

STATE OF Kansas, COUNTY OF Sedgwick, ss.
(employee of owner) or (owner or operator) of the above-described well, being first duly sworn on oath, says: That I have knowledge of the facts, statements, and matters herein contained and the log of the above-described well as filed and that the same are true and correct. So help me God.

(Signature)

Harvey F. German
502 Petroleum Building, Wichita, Kansas
(Address)

SUBSCRIBED AND SWORN TO before me this 24th day of May, 19 65

My commission expires February 28th, 1968

Geneva M. German


Notary Public.

OPERATOR: G D & W Oil Co.
Wichita, KansasLOCATION: NW-NW-NE
17-24s-3w
Harvey County
KansasCONTRACTOR: German Drilling Company
502 Petroleum Building
Wichita, KansasFarm: Boyle
Date Commenced: 5-10-65
Date Completed: 5-22-65Well No. #1
Rotary

From	To	Formation
0	171	Sand
171	315	Sand, shale
315	520	Shale, lime
520	630	Shale, lime
630	1026	Lime, shale
1026	1075	Lime, shale
1075	1164	Shale, lime
1164	1378	Shale, lime
1378	1750	Shale, lime
1750	2095	Shale, lime
2095	2185	Shale, lime
2185	2285	Shale, lime
2285	2431	Shale, lime
2431	2466	Lime, shale
2466	2570	Shale, lime
2570	2656	Shale, lime
2656	2712	Lime, shale
2712	2875	Lime
2875	2983	Lime
2983	3060	Lime, shale
3060	3168	Lime
3168	3191	Lime
3191	3262	Lime
3262	3282	Shale, lime
3282	3395	Shale
3282	3410	Lime (Mississippi)
3395	3432	Lime
3410	3481	Lime
3432	3576	Chert, lime
3481	3632	Lime, chert
3576	3632	Lime, shale
3632	3668	Lime, shale
3668	3694	Lime, shale
3694	3732	Shale, lime
3732	3737	Lime, shale
3737	3765	Lime
3765	3789	Shale
3789	3797	Shale
3797	3827	Lime, shale (Hunton)
3827	3898	Shale, lime
3898	3915	Lime
3915	3940	Sand
3940	3945	Sand
3945		TD

I hereby certify that the foregoing is a true and correct copy of the Well Log for the Boyle #1, drilled for G D & W Oil Co. and completed May 22, 1965.


GERMAN DRILLING COMPANY

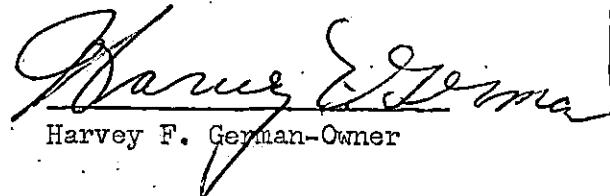

Harvey F. German
Owner

Surface: ----
Production: ----STATE OF KANSAS)
STATE OF KANSAS)
COUNTY OF SEDGWICK)
COUNTY OF SEDGWICK)

Subscribed and sworn to, before the undersigned, a Notary Public, in and for County and State aforesaid, this twenty-fourth day of May, 1965.

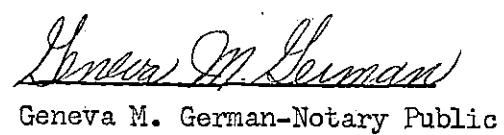

Geneva M. German
Notary Public

My Commission Expires February 28th, 1965