


STATE OF KANSAS
STATE CORPORATION COMMISSION

15-079-00023-0000

Give All Information Completely
Make Required Affidavit
Mail or Deliver Report to:
Conservation Division
State Corporation Commission
800 Bittling Building
Wichita, Kansas

WELL PLUGGING RECORD

NORTH

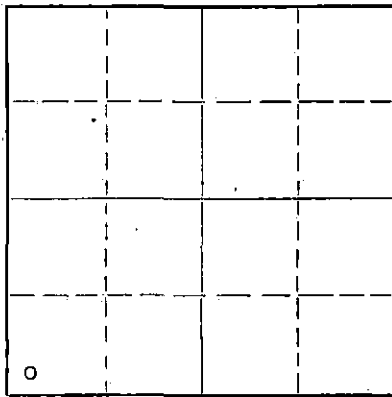

Locate well correctly on above
Section Plat

Harvey County. Sec. 34 Twp. 24 Rge. (E) 3 (W)
Location as "NE/CNW/SW" or footage from lines SW SW SW
Lease Owner Graham-Messman-Rinehart Oil Company
Lease Name Baird Well No. 1
Office Address P. O. Box 1033, Wichita, Kansas
Character of Well (completed as Oil, Gas or Dry Hole) Dry Hole
Date well completed June 3, 19 53
Application for plugging filed June 3, 19 53
Application for plugging approved June 6, 19 53
Plugging commenced June 3, 19 53
Plugging completed June 3, 19 53
Reason for abandonment of well or producing formation Dry

If a producing well is abandoned, date of last production 19
Was permission obtained from the Conservation Division or its agents before plugging was commenced? yes

Name of Conservation Agent who supervised plugging of this well Mr. Ruel Durkee, Box 597, McPherson, Ks.
Producing formation Depth to top Bottom Total Depth of Well 4036 Feet
Show depth and thickness of all water, oil and gas formations.

OIL, GAS OR WATER RECORDS

CASING RECORD

FORMATION	CONTENT	FROM	TO	SIZE	PUT IN	PULLED OUT
				1-3-3/8"	200'	none
				8-5/8"	512'	none

Describe in detail the manner in which the well was plugged, indicating where the mud fluid was placed and the method or methods used in introducing it into the hole. If cement or other plugs were used, state the character of same and depth placed, from feet to feet for each plug set.

First plug @ 375 ft. and cemented with 20 sx. thru 9 jts. of pipe. Bridge on top of first plug with chat and 1/2 sk. of hulls. Top plug @ 30 ft. and cemented with 10 sx. cement. Mud to surface.

6-20-53

RECEIVED
STATE CORPORATION COMMISSION
WICHITA, KANSAS

(If additional description is necessary, use BACK of this sheet)
Name of Plugging Contractor Graham-Messman-Rinehart Oil Company
Address P. O. Box 1033, Wichita, Kansas


STATE OF Kansas, COUNTY OF Sedgwick, ss.
J. A. Gilliland (employee of owner or owner or operator) of the above-described well, being first duly sworn on oath, says: That I have knowledge of the facts, statements, and matters herein contained and the log of the above-described well as filed and that the same are true and correct. So help me God.

(Signature) *J. A. Gilliland*
P. O. Box 1033, Wichita, Kansas
(Address)

SUBSCRIBED AND SWORN to before me this 10th day of June, 19 53

My commission expires December 1, 1956

Barbara J. Scott
Notary Public.

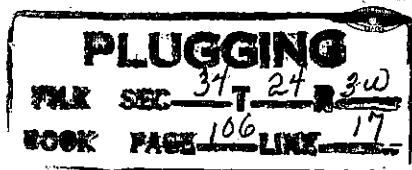

15-079-00023-0000

BAIRD #1

WELL RECORD

Location: Sec 34 Twp. 24 Range 3w, SWSW SW
Harvey County, Kansas

Operator: Graham-Messman-Rinehart Oil Company

Contractor: Graham-Messman-Rinehart Drilling Co.

Casing Record: 13 3/8" @ 200' w/150 ex. cem.
4 c.c.'s 3 Gal.
8 5/8" @ 512' w/50 ex. cem.

Commenced: May 16, 1953

Completed: June 3, 1953

Elevation: 1433 K. B.

Production: D & A

LOG

Sand & Clay 160

Sand & Shale 200

Shale & Shells 459

Shale & Shells 495

Shale & Sand 512

Shale & Shells 780

Shale & Shells 935

Shale-Lime 1080

Shale-Lime 1810

Shale-Lime 2046

Shale-Lime 2128

Shale-Lime 2320

Shale-Lime 2495

Shale-Lime 2528

Shale-Lime 2586

Shale-Lime 2688

Shale-Lime 2752

Shale-Lime 2870

Lime 2939

Lime 2984

Lime 3034

Lime 3072

Lime 3135

Lime & Shale 3200

Lime 3240

Lime 3305

Lime & Shale 3380

Lime & Shale 3425

Lime & Shale 3480

Lime-Chert 3516

Lime-Chert 3575

Lime-Chert 3605

Lime-Chert 3665

Lime-Chert 3696

Lime-Chert 3710

Lime-Chert 3745

Lime-Chert 3763

Lime-Chert 3786

Lime-Shale 3808

Lime-Shale 3829

Lime 3837

Lime-Chert 3903

Lime-Shale 3953

Lime-Shale 3984

Lime-Shale 3985

Lime-Shale 4011

Lime-Shale 4035

TOPS

###	3425	Miss.	(-1992)
	3840	Kind.	(-2407)
	3884	Hunt.	(-2451)
	3947	Vio.	(-2514)
	3970	Simp.	(-2537)
	4036	TD.	

6-20-58

RECEIVED
STATE OF KANSAS DEPARTMENT OF CONSERVATION
JUN 20 1953
CONSERVATION DIVISION

The undersigned, Graham-Messman-Rinehart Oil Company, hereby certifies that the above log is a true and correct log of the formation encountered in drilling the above well as reflected by the Daily Drilling Reports.

GRAHAM-MESSMAN-RINEHART OIL COMPANY
By J. H. Heland

Subscribed and sworn to before me this
19th day of June, 1953
Richard J. Scott
Notary Public

PLUGGING
FILE SEC-T-R
BOOK PAGE-LINE