


15-047-20496-0000

STATE OF KANSAS
STATE CORPORATION COMMISSION

WELL PLUGGING RECORD

Give All Information Completely
Make Required Affidavit
Mail or Deliver Report to
Conservation Division
State Corporation Comm.
245 North Water
Wichita, KS 67202

Edwards County. Sec. 33 Twp. 24S Rge. 16W E/W
Location as "NE/CNW $\frac{1}{4}$ SW $\frac{1}{4}$ " or footage from lines
C SW NW
Lease Owner F. G. Holl
Lease Name Laremore #1-33 Well No. 1-33
Office Address 6427 East Kellogg, Wichita, Kansas 67207
Character of Well (Completed as Oil, Gas or Dry Hole)

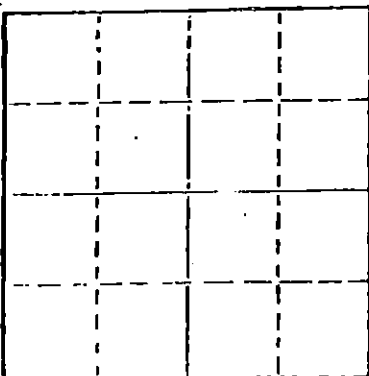

Locate well correctly on above
Section Plat

Dry Hole
Date Well completed April 12, 1979 19
Application for plugging filed April 12, 1979 19
Application for plugging approved April 12, 1979 19
Plugging commenced 10:30 AM, April 12, 1979 19
Plugging completed 12:00 Noon - April 12, 1979 19
Reason for abandonment of well or producing formation
Dry Hole

If a producing well is abandoned, date of last production 19

Was permission obtained from the Conservation Division or its agents before plugging was commenced? Yes

Name of Conservation Agent who supervised plugging of this well Bill Owen
Producing formation _____ Depth to top _____ Bottom _____ Total Depth of Well 4475'
Show depth and thickness of all water, oil and gas formations.

OIL, GAS OR WATER RECORDS

CASING RECORD

FORMATION	CONTENT	FROM	TO	SIZE	PUT IN	PULLED OUT
				8 5/8"	262'	None

Describe in detail the manner in which the well was plugged, indicating where the mud fluid was placed and the method or methods used in introducing it into the hold. If cement or other plugs were used, state the character of same and depth placed, from _____ feet to _____ feet for each plug set.

Filled hole with heavy mud.
Pumped through open end Drill Pipe
40 sacks at 540'; 40 sacks at 260';
solid bridge at 40' with plug and 1/2
sack hulls with 12 sackd to surface,
3 sacks in rat hole.

4-25-79

RECEIVED
STATE CORPORATION COMMISSION

APR 25 1979

CONSERVATION DIVISION
Wichita, Kansas

(If additional description is necessary, use BACK of this sheet)

Name of Plugging Contractor Sterling Drilling Company, P. O. Box 129, Sterling, Kansas 67579

STATE OF KANSAS COUNTY OF RICE, ss.
F. A. Wuellner (employee of owner) or (owner or operator)
of the above-described well, being first duly sworn on oath, says: That I have knowledge of the facts, statements, and matters herein contained and the log of the above-described well as filed and that the same are true and correct. So help me God.

(Signature) F. A. Wuellner
STERLING DRILLING COMPANY
F. A. Wuellner, Secretary
P. O. Box 129, Sterling, Kansas 67579
(Address)

SUBSCRIBED AND SWORN TO before me this 16th day of April, 1979



Charles M. Hall
Charles M. Hall, Notary Public.

My commission expires

15-047-20496-0000

STERLING DRILLING COMPANY
P. O. Box 129
Sterling, Kansas 67579

WELL LOG ----- LAPEERE #1-33
Located: C E 1 W 1, Sec. 33-24S-16W, Edwards County, Kansas

OWNER: F. G. Holl
ROTARY DRILLING CONTRACTOR: Sterling Drilling Company

COMMENCED: April 6, 1979
COMPLETED: April 12, 1979

TOTAL DEPTH: 4475'

<u>LOG</u>	<u>CASING RECORD</u>
0 - 265 Shale and Sand	Ran 6 joints used 28#, 8 5/8" casing,
265 - 363 Shale and Red Beds	250.32' set at 262' K.B. with 225 sacks
363 - 1094 Shale, Sand and Red Bed	60/40 Pozmix with 3% cc. Plug down at
1094 - 1107 Anhydrite	2:15 PM, 4-6-79, by Howco.
1107 - 1613 Shale	
1613 - 2078 Shale and Salt	
2078 - 4340 Lime and Shale	
4340 - 4365 Chert and Shale	
4365 - 4475 Lime and Shale	Plugged.

4-25-79

RECEIVED
STATE CORPORATION COMMISSION

APR 25 1979

CONSERVATION DIVISION
Wichita, Kansas