


STATE OF KANSAS
STATE CORPORATION COMMISSION
Give All Information Completely
Make Required Affidavit
Mail or Deliver Report to:
Conservation Division
State Corporation Commission
800 Bittling Building
Wichita, Kansas

WELL PLUGGING RECORD

FORMATION PLUGGING RECORD

Strike out upper line when reporting plugging of formations.

Edwards County. Sec. 15 Twp. 24S Rge. (E) 17 (W)
Location as "NE1/4NW1/4SW1/4" or footage from lines 330' from S & E lines of
Lease Owner Skelly Oil Company S/2
Lease Name E. F. Miller Well No. 1
Office Address Box 391, Hutchinson, Kansas
Character of Well (completed as Oil, Gas or Dry Hole) Dry Hole
Date well completed December 29, 1946
Application for plugging filed December 30, 1946
Application for plugging approved January 7, 1947
Plugging commenced December 30, 1946
Plugging completed December 30, 1946
Reason for abandonment of well or producing formation Dry Hole

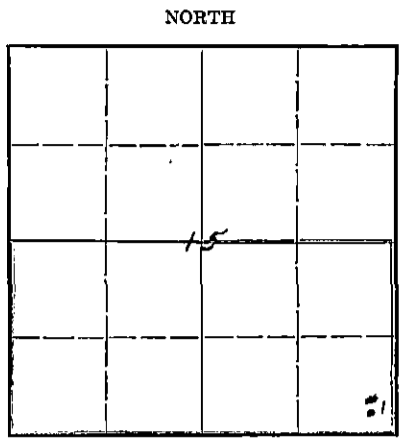

Locate well correctly on above Section Plat

If a producing well is abandoned, date of last production 19
Was permission obtained from the Conservation Division or its agents before plugging was commenced? Yes (verbally)

Name of Conservation Agent who supervised plugging of this well H. W. Kerr
Producing formation Dry Hole Depth to top Bottom Total Depth of Well 4720 Feet
Show depth and thickness of all water, oil and gas formations.

OIL, GAS OR WATER RECORDS


CASING RECORD

Formation	Content	From	To	Size	Put In	Pulled Out
Arbuckle Lime	Water	4673'	4720'	16" OD	9719"	None
				10-3/4"	106410"	None

Describe in detail the manner in which the well was plugged, indicating where the mud fluid was placed and the method or methods used in introducing it into the hole. If cement or other plugs were used, state the character of same and depth placed, from feet to feet for each plug set.

75 sacks of cement 4720' to 4540'
Mud laden fluid 4540' to 300'
15 sacks of cement 300' to 273'
Mud laden fluid 273' to 25'
10 sacks of cement 25' to 9'
Surface soil 9' to 0'

1-28-47

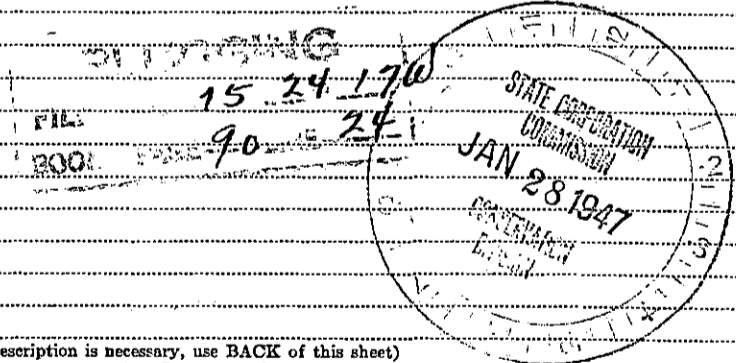

(If additional description is necessary, use BACK of this sheet)

Correspondence regarding this well should be addressed to Skelly Oil Company
Address Box 391, Hutchinson, Kansas

STATE OF Kansas, COUNTY OF Reno, ss.

H. E. Wamsley (employee of owner) or (owner) of the above-described well, being first duly sworn on oath, says: That I have knowledge of the facts, statements, and matters herein contained and the log of the above-described well as filed and that the same are true and correct. So help me God.

(Signature) [Signature]
Box 391, Hutchinson, Kansas (Address)

SUBSCRIBED AND SWORN to before me this 27th day of January, 1947.

My commission expires April 7, 1947

[Signature] Notary Public.