


Give All Information Completely
Make Required Affidavit
Mail or Deliver Report to:
Conservation Division
State Corporation Commission
211 No. Broadway
Wichita, Kansas

WELL PLUGGING RECORD

NORTH 22 8-8 W

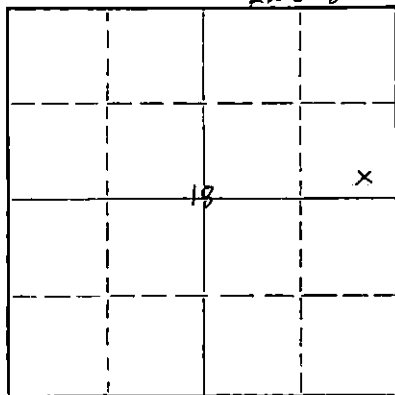

Locate well correctly on above Section Plat

Reno County, Sec. 18 Twp. 22 Rge. 8 (E) W (W)
Location as "NE/CNW/SW" or footage from line 50' SE of C SENE
Lease Owner Mull Drilling Co. Inc
Lease Name Stavely Well No. 1
Office Address 670 N. 4th. Natl. Bank Bldg. Wichita, Kansas
Character of Well (completed as Oil, Gas or Dry Hole) Dry hole.
Date well completed 1-11-62 19
Application for plugging filed 1-11-62 19
Application for plugging approved 1-14-62 19
Plugging commenced 11:00 P. M. 1-11-62 19
Plugging completed 7:00 A. M. 1-11-62 19
Reason for abandonment of well or producing formation Non Productive.

If a producing well is abandoned, date of last production 19
Was permission obtained from the Conservation Division or its agents before plugging was commenced? Yes

Name of Conservation Agent who supervised plugging of this well Fred Hampel
Producing formation _____ Depth to top _____ Bottom _____ Total Depth of Well 3565' Feet
Show depth and thickness of all water, oil and gas formations.

OIL, GAS OR WATER RECORDS

CASING RECORD

FORMATION	CONTENT	FROM	TO	SIZE	PUT IN	PULLED OUT

Describe in detail the manner in which the well was plugged, indicating where the mud fluid was placed and the method or methods used in introducing it into the hole. If cement or other plugs were used, state the character of same and depth placed, from _____ feet to _____ feet for each plug set.

Plug put at 220' with 1/4 sack hulls added to top and 20 sacks cement added. Mud to 40' a plug and 1/4 sack hulls and 10 sacks cement. Two sacks put in rat hole plugging same. This completed plugging of well.

5-10-62
RECEIVED
STATE CORPORATION COMMISSION
MAY 10 1962
CONSERVATION DIVISION
Wichita, Kansas

(If additional description is necessary, use BACK of this sheet)
Name of Plugging Contractor Co. tools.
Address Same as above.

STATE OF KANSAS, COUNTY OF SEDGWICK, ss.
Joseph O. Butts (employee of owner) or (owner or operator) of the above-described well, being first duly sworn on oath, says: That I have knowledge of the facts, statements, and matters herein contained and the log of the above-described well as filed and that the same are true and correct. So help me God.

(Signature) Joseph O. Butts
Wichita, Kansas (Address)

SUBSCRIBED AND SWORN TO before me this 4th day of May, 1962

My commission expires October 16, 1965
Notary Public.



ROTARY DRILLERS LOG

COMPANY: Hull Drilling Co., Inc. et al
Wichita, Kansas

ROTARY DRILLING COMMENCED: 4/14/62

CONTRACTOR: Hull Drilling Co., Inc.
Wichita, Kansas

ROTARY DRILLING COMPLETED: 4/20/62

CASING RECORD: Set 220" of 8 5/8" csg w/175 at ext.
D & A

LOCATION: STAVELY #1
150' SE of C SE NE
18-27S-8W
Reno County, Kansas

(Figures indicate bottom of formation - measurements from top of Rotary Bushing.)

550'	Red bed
1200'	Shale & Shells
1500'	Shale w/Lime
3260'	Lime & Shale
3400'	Lime
3507'	Lime & Shale
3533'	Cherokee
3549'	Mississippi
3563'	Conglomerate
3565'	Kinderhook - total depth

5-10-62
RECEIVED
STATE CORPORATION COMMISSION
MAY 10 1962
CONSERVATION DIVISION
Wichita, Kansas

I hereby certify that this is a true and correct copy of the above log to the best of my knowledge.

HULL DRILLING COMPANY, INC.

Delbert J. Gosta
Delbert J. Gosta, Geologist

STATE OF KANSAS)
) SS
COUNTY OF SEDGWICK)

Subscribed and sworn to before me this 8th day of May, 1962.



Maden H. Miller
Notary Public

Commission Expires: Feb. 24, 1964