TYPE

SIDE ONE

AFFIDAVIT OF COMPLETION FORM — ACO-1 WELL HISTORY

Two (2) copies of this form shall be filed with the Kansas Corporation Commission, 200 Colorado Derby Building, Wichita, Kansas 67202, within thirty (30) days after the completion of a well, regardless of how the well was completed.

X Attach separate letter of request if the information is to be held confidential. If confidential, only file one copy. Information on Side One will be of public record and Side Two will then be held confidential.

Applications must be made on dual completion, commingling, salt water disposal, injection and temporarily abandoned wells.

X Attach one copy only wireline logs (i.e. electrical log, sonic log, gamma ray neutron log, etc.). (Rules 82-2-105 & 82-2-125) KCC# (316) 263-3238.

LICENSE # 5606 EXPIRATION DATE 6/30/83

OPERATOR R. J. Walker Oil Co., Inc. API NO. 15-155-20,893-0000

ADDRESS 3524 N. W. 56th Street COUNTY Reno

Oklahoma City, Oklahoma 73112 FIELD WILDCAT

** CONTACT PERSON O. N. Goode PROD. FORMATION NONE

PHONE 405-949-2440

PURCHASER NONE LEASE F. M. Goertzen

ADDRESS _____ WELL NO. 1-8

WELL LOCATION SE, NW, SW

DRILLING CONTRACTOR Kansas Drilling & Well Serv., Inc. 1650 Ft. from South Line and

ADDRESS Box 254 990 Ft. from West Line of


Marion, Kansas 66861 the SW (Qtr.) SEC 8 TWP 22 RGE 4W.

PLUGGING CONTRACTOR Kansas Drilling & Well Serv., Inc.

ADDRESS Box 254

Marion, Kansas 66861

WELL PLAT

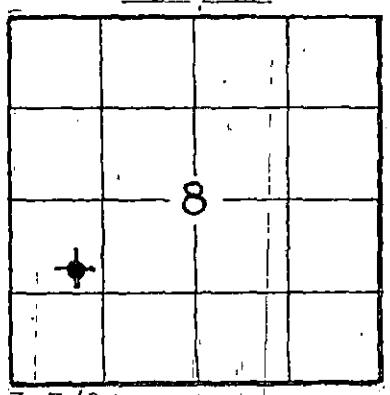

(Office Use Only)
KCC ✓
KGS ✓
SWD/REP__
PLG.__

TOTAL DEPTH 4050' PBTD NONE

SPUD DATE 8-31-82 DATE COMPLETED 9-9-82

ELEV: GR 1527' DF 1533' KB 1535'

DRILLED WITH (~~CABLE~~) (ROTARY) (~~AIR~~) TOOLS.

DOCKET NO. OF DISPOSAL OR REPRESSURING WELL BEING USED TO DISPOSE OF WATER FROM THIS LEASE NO DISPOSAL.

Amount of surface pipe set and cemented 209' KB of 13 3/8" DV Tool Used? No.
706' KB of 8 5/8"

THIS AFFIDAVIT APPLIES TO: (Circle ONE) - Oil, Gas, Shut-in Gas, (Dry) Disposal, Injection, Temporarily Abandoned, OWWO. Other_____.

ALL REQUIREMENTS OF THE STATUTES, RULES AND REGULATIONS PROMULGATED TO REGULATE THE OIL AND GAS INDUSTRY HAVE BEEN FULLY COMPLIED WITH.

A F F I D A V I T

O.N. Goode, Jr., being of lawful age, hereby certifies that:

I am the Affiant, and I am familiar with the contents of the foregoing Affidavit. The statements and allegations contained therein are true and correct to the best of my knowledge.

O. N. Goode
(Name)

SUBSCRIBED AND SWORN TO BEFORE ME this 19th day of October, 1982.

Mary Kay Modrick
(NOTARY PUBLIC)

MY COMMISSION EXPIRES: February 19th, 1985

** The person who can be reached by phone regarding any questions concerning this information.

OCT 20 1982

CONSERVATION DIVISION
Wichita, Kansas

10-20-82