

This form shall be filed in duplicate with the Kansas Corporation Commission, 200 Colorado Derby Building, Wichita, Kansas 67202, within ten days after the completion of the well, regardless of how the well was completed.

Attach separate letter of request if the information is to be held confidential. If confidential, only file one copy. Information on side one will be of public record and side two will then be held confidential.

Circle one: Oil, Gas, Dry SWD, OWWO, Injection. Type and complete ALL sections. Applications must be filed for dual completion, commingling, SWD and injection, T.A.

Attach wireline logs (i.e. electrical log, sonic log, gamma ray neutron log, etc.). KCC # (316) 263-3238. (Rules 82-2-105 & 82-2-125)

OPERATOR R. J. Walker Oil Co., Inc.

API NO. 15-155-20,859-0000

ADDRESS 3524 N. W. 56th Street

COUNTY Reno

Oklahoma City, Oklahoma 73112

FIELD Wildcat

\*\*CONTACT PERSON Oscar Goode

PROD. FORMATION None

PHONE 405-949-2440

LEASE W. Bontrager

PURCHASER None

WELL NO. 1-18

ADDRESS

WELL LOCATION NW NE NW

DRILLING Kansas Drilling & Well Serv., Inc.

330 Ft. from North Line and

CONTRACTOR

1630 Ft. from West Line of

ADDRESS Box 254

the SEC. 18 TWP. 22 RGE. 4W

Marion, Kansas 66861


WELL PLAT

PLUGGING Kansas Drilling & Well Service, Inc.

CONTRACTOR

ADDRESS Box 254

Marion, KS 66861

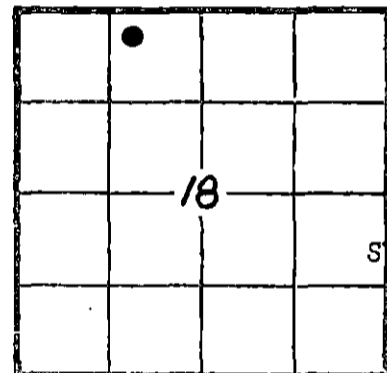

KCC \_\_\_ KGS \_\_\_ (Office Use)

TOTAL DEPTH 3980' PBTD

SPUD DATE 1-4-82 DATE COMPLETED 1-24-82

ELEV: GR 1475' DF 1481' KB 1483'

DRILLED WITH (CABLE) (ROTARY) (AIR) TOOLS

Amount of surface pipe set and cemented 140'KB

DV Tool Used? NO

RECEIVED STATE CORPORATION COMMISSION 3-4-82 MAR 4 1982 CONSERVATION DIVISION Wichita, Kansas

AFFIDAVIT

STATE OF Oklahoma, COUNTY OF Oklahoma ss, I,

O. N. Goode, Jr. OF LAWFUL AGE, BEING FIRST DULY SWORN UPON HIS OATH,

DEPOSES THAT HE IS V.P. - Engineering (FOR)XXX R. J. Walker Oil Co., Inc.

OPERATOR OF THE W. Bontrager LEASE, AND IS DULY AUTHORIZED TO MAKE

THIS AFFIDAVIT FOR AND ON THE BEHALF OF SAID OPERATOR, THAT WELL NO. 1-18 ON

SAID LEASE HAS BEEN COMPLETED AS OF THE 24th DAY OF January, 19 82, AND THAT

ALL INFORMATION ENTERED HEREIN WITH RESPECT TO SAID WELL IS TRUE AND CORRECT.

FURTHER AFFIANT SAITH NOT.

SUBSCRIBED AND SWORN BEFORE ME THIS 2nd DAY OF March, 19 82.

(S) O. N. Goode, Jr. Mary Kay Modrak NOTARY PUBLIC

MY COMMISSION EXPIRES: February 19, 1985

\*\*The person who can be reached by phone regarding any questions concerning this information. Within 45 days of completion, a witnessed initial test by the Commission is required if the well produces more than 25 BOPD or is located in a Basic Order Pool.

**SIDE TWO**

**WELL LOG**

Show all important zones of porosity and contents thereof; cored intervals, and all drill-stem tests, including depth interval tested, cushion used, time tool open, flowing and shut-in pressures, and recoveries.

SHOW GEOLOGICAL MARKERS, LOGS RUN, OR OTHER DESCRIPTIVE INFORMATION.

FORMATION DESCRIPTION, CONTENTS, ETC.		TOP	BOTTOM	NAME	DEPTH
0-2664	lime, shale				
2664-2765	Lansing				
2765-2930	Lans lime				
2930-3343	K.C.				
3343-3580	Miss				
3580-3720	Kinderhook				
3720-3793	Shale				
3793-3872	Kinderhook				
3872-3965	Simpson				
3965-3980	Arbuckle				
3980	TD				
"Drillers Log"					

**Report of all strings set— surface, intermediate, production, etc. CASING RECORD (New) or (Used)**

Purpose of string	Size hole drilled	Size casing set (in O.D.)	Weight lbs/ft.	Setting depth	Type cement	Sacks	Type and percent additives
Surface	12 1/4"	13 3/8"	61	140'	Class A Common	150	3% CACL

**LINER RECORD**

**PERFORATION RECORD**

Top, ft.	Bottom, ft.	Sacks cement	Shots per ft.	Size & type	Depth interval

TUBING RECORD		
Size	Setting depth	Packer set at

**ACID, FRACTURE, SHOT, CEMENT SQUEEZE RECORD**

Amount and kind of material used	Depth interval treated

Date of first production	Producing method (flowing, pumping, gas lift, etc.)	Gravity
<b>RATE OF PRODUCTION PER 24 HOURS</b>	Oil bbls.	Gas MCF
Disposition of gas (vented, used on lease or sold)	Water %	Gas-oil ratio bbls. CFPB
Perforations		