


STATE OF KANSAS  
STATE CORPORATION COMMISSION

WELL PLUGGING RECORD

Give All Information Completely  
Make Required Affidavit  
Mail or Deliver Report to  
Conservation Division  
State Corporation Comm.  
245 North Water  
Wichita, KS 67202

Hodgeman County, Sec. 11 Twp. 24 S Rge. 22 E/W  
Location as "NE/CNW $\frac{1}{4}$ SW $\frac{1}{4}$ " or footage from lines  
C NW NE

Lease Owner Denver Energy Investments  
Lease Name Hall A Well No. 1  
Office Address 703 American Nat'l Bank Bldg., Denver,  
Character of Well (Completed as Oil, Gas or Dry Hole) COLO.  
oil 8020Z

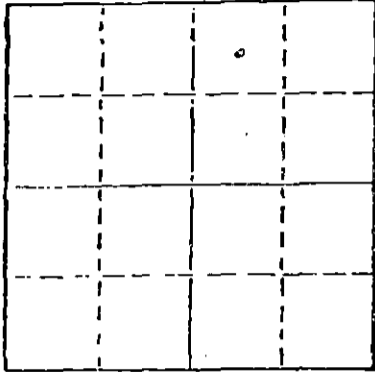

Locate well correctly on above  
Section Plot

Date Well completed 19  
Application for plugging filed Oct. 30 19 79  
Application for plugging approved 19  
Plugging commenced Jan. 7 19 80  
Plugging completed Jan. 14 19 80  
Reason for abandonment of well or producing formation  
depleted

If a producing well is abandoned, date of last production  
19

Was permission obtained from the Conservation Division or  
its agents before plugging was commenced? yes

Name of Conservation Agent who supervised plugging of this well Clarence Thomas, Jr.  
Producing formation Depth to top Bottom Total Depth of Well 4668'  
Show depth and thickness of all water, oil and gas formations.

OIL, GAS OR WATER RECORDS

CASING RECORD

FORMATION	CONTENT	FROM	TO	SIZE	PUT IN	PULLED OUT
			254'	8 5/8"	254'	none
			4661'	4 1/2"	4661'	2539.07

Describe in detail the manner in which the well was plugged, indicating where the mud fluid  
was placed and the method or methods used in introducing it into the hold. If cement or other  
plugs were used, state the character of same and depth placed, from \_\_\_\_\_ feet to  
\_\_\_\_\_ feet for each plug set.

Allied Cementing Company plugged bottom pumping in 1 sack of hulls and 15  
sacks of cement. Spotted plug at 4400'.

Allied Cementing Company plugged well pumping in 4 sacks of hulls, 24 sacks  
of gel and 90 sacks of cement.

(If additional description is necessary, use BACK of this sheet)

Name of Plugging Contractor GLENNS CASING PULLING INC.  
Box 413, Ellinwood, Kansas 67526

STATE OF KANSAS COUNTY OF BARTON, ss.  
Evelyn Roth (employee of owner) or (owner or operator)  
of the above-described well, being first duly sworn on oath, says: That I have knowledge of  
the facts, statements, and matters herein contained and the log of the above-described well  
as filed and that the same are true and correct. So help me God.

(Signature) Evelyn Roth  
Ellinwood, Kansas  
(Address)

SUBSCRIBED AND SWORN TO before me this 15th day of January, 1980



George A. Meyer  
Notary Public.  
RECEIVED  
STATE CORPORATION COMMISSION

My commission expires

JAN 16 1980 1-16-80

KANSAS DRILLERS LOG

COMPANY Denver Energy Investments

SEC. 11 T. 24S R. 22W

FARM Hall "A"

NO. 1

LOC. C- NW NE

COUNTY Hodgeman

ROTARY TOTAL DEPTH 4,668'

COMM. July 29, 1978

COMP. August 9, 1978

CONTRACTOR H-30, Inc.

ISSUED August 16, 1978

CASING

10 3/4"

8 5/8" Set at 254' cemented w/175 sxs cement

5 1/2"

4 1/2" Set at 4,660' cemented w/125 sxs cement

ELEVATION 2,296 K.B.

FIGURES INDICATE BOTTOM OF FORMATIONS

Sand and Shale	255'
Shale and Red Bed	880'
Sand	1,080'
Shale	1,395'
Anhydrite	1,434'
Shale and Lime	1,945'
Lime and Shale	2,830'
Lime	3,040'
Lime and Shale	3,425'
Lime	3,825'
Lime and Shale	3,988'
Lime	4,180'
Lime and Shale	4,279'
Lime	4,575'
Lime and Chert	4,605'
Lime	4,668'
Rotary Total Depth	4,668'

I hereby certify the above and foregoing to be a true and correct log of the above described well as shown by the drilling reports.

H-30, Inc.

11-29-79 RECEIVED STATE OF KANSAS COMMISSION NOV 29 1979 DEAN BRITTING

State of Kansas } ss: County of Sedgwick }

Subscribed and Sworn to before me a Notary Public in and for said county and state this 16th day of August, 1978.



Elsie Willison - Notary Public

My Commission Expires: July 25, 1982