


STATE OF KANSAS  
STATE CORPORATION COMMISSION  
Give All Information Completely  
Make Required Affidavit  
Mail or Deliver Report to:  
Conservation Division  
State Corporation Commission  
211 No. Broadway  
Wichita, Kansas

### WELL PLUGGING RECORD

Hodgeman Hodgeman County, Sec. 15 Twp. 24 Rge. (E) 21 (W)  
Location as "NE/CNW/SW" or footage from lines C SW NW  
Lease Owner James W. Hershberger  
Lease Name Burmeister Well No. 1  
Office Address 1039 1st Nat'l Bldg., Wichita, Kansas  
Character of Well (completed as Oil, Gas or Dry Hole) Dry hole  
Date well completed 1/12/64 19 64  
Application for plugging filed 1/12 19 64  
Application for plugging approved 1/12 19 64  
Plugging commenced 1/12 19 64  
Plugging completed 1/12 5 P. M. 19 64  
Reason for abandonment of well or producing formation Dry

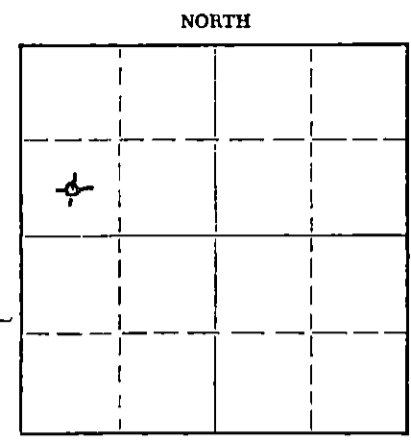

Locate well correctly on above Section Plat

Name of Conservation Agent who supervised plugging of this well Hugh Scott  
Producing formation dry hole Depth to top \_\_\_\_\_ Bottom \_\_\_\_\_ Total Depth of Well 4844 Feet  
Show depth and thickness of all water, oil and gas formations.

OIL, GAS OR WATER RECORDS				CASING RECORD		
FORMATION	CONTENT	FROM	TO	SIZE	PUT IN	PULLED OUT
Lansing	Water	4102	4465	8 5/8	296'	None
Mississippi	Water	4703	4844			

Describe in detail the manner in which the well was plugged, indicating where the mud fluid was placed and the method or methods used in introducing it into the hole. If cement or other plugs were used, state the character of same and depth placed, from \_\_\_\_\_ feet to \_\_\_\_\_ feet for each plug set.  
Fill up mud to 700'. Pump cement  
Plug of 25 sax cement w/Sun truck. Mud to 290'. Plug  
25 sax cement pumped w/truck. Mud to 40. Plug with  
hulls and 15 sax cement

**RECEIVED**  
STATE CORPORATION COMMISSION  
1-23-64  
JAN 23 1964

CONSERVATION DIVISION  
Wichita, Kansas

(If additional description is necessary, use BACK of this sheet)  
Name of Plugging Contractor \_\_\_\_\_  
Address \_\_\_\_\_

STATE OF Florida, COUNTY OF Dade, ss.  
Joseph Toichman (employee of owner) or (owner or operator) of the above-described well, being first duly sworn on oath, says: That I have knowledge of the facts, statements, and matters herein contained and the log of the above-described well as filed and that the same are true and correct. So help me God.

(Signature) Joseph Toichman  
2451 Brickell Ave., Miami 36, Fla.  
(Address)

SUBSCRIBED AND SWORN TO before me this 17 day of January, 19 64

NOTARY PUBLIC STATE of FLORIDA at LARGE  
MY COMMISSION EXPIRES APR. 2, 1967

Louise G. Lippert  
Notary Public.

My commission expires BONDED THROUGH FRED W. DIESTELHORST

15-083-00261-0000

SHOLOM DRILLING COMPANY, INC.  
2451 Brickell Avenue  
Miami, Florida

COMPANY: James W. Hershberger Oil Co.  
FARM: #1 Burnmeister  
LOCATION: C SW NW Sec. 15 T24S R 21W  
ROTARY DRILLING CONTRACTOR: Sholom Drilling Company, Inc.

COMMENCED: 12-27-63  
COMPLETED: 1-12-64  
I.P. : D & A

Elevation 2340' K.B.  
2332' G.L.  
Rotary TD: 4844'

Casing Record:  
8-8/8" @ 296' W/150sax

LOG

- 0 - 45 Clay & Post Rock
- 45 - 400 Shale
- 400 - 600 Shale & Shells
- 600 - 820 Red Bed & Shale
- 820 - 840 Anhydrite
- 840 - 920 Red Bed & Shale
- 920 - 1030 Sand
- 1030 - 1437 Shale & Shells
- 1437 - 1520 Anhydrite
- 1520 - 1820 Shale & Shell
- 1820 - 2345 Lime & Shale
- 2345 - 2550 Lime
- 2550 - 2600 Lime & Shale
- 2600 - 2700 Lime
- 2700 - 2935 Hard Lime
- 2935 - 3030 Lime
- 3030 - 4090 Lime & Shale
- 4090 - 4394 Lime
- 4394 - 4450 Lime & Shale
- 4450 - 4730 Lime
- 4730 - 4894 Lime & Chert

Lansing 4102'  
Mississippi 4703'


DST 4703-17 15' WUD  
BHF 1330# - 1120#  
FPO -0

**RECEIVED**  
STATE CORPORATION COMMISSION  
  
JAN 23 1964  
1-23-64  
CONSERVATION DIVISION  
Wichita, Kansas


STATE OF FLORIDA )  
                          ) SS.  
COUNTY OF DADE )

I, Joseph Teichman, President of Sholom Drilling Company, Inc.

a corporation of the State of Oklahoma, domesticated in the State of Kansas, being first duly sworn under oath, says: That I have knowledge of the facts, statements, and matters herein contained of the above described well as filed and that the same are true and correct.

  
Joseph Teichman

Subscribed and sworn to before me this 17th day of January, 1964

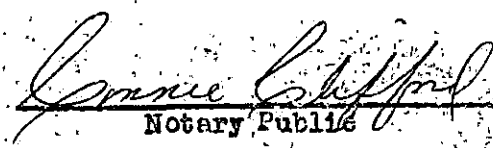  
Notary Public

NOTARY PUBLIC STATE of FLORIDA at LARGE  
MY COMMISSION EXPIRES APR. 2, 1967  
BONDED THROUGH FRED W. DIESTELHORST  
My commission expires \_\_\_\_\_