


STATE OF KANSAS
STATE CORPORATION COMMISSION

WELL PLUGGING RECORD

Give All Information Completely
Make Required Affidavit
Mail or Deliver Report to
Conservation Division
State Corporation Comm.
245 North Water
Wichita, KS 67202

Hodgeman County, Sec. 1 Twp. 24S Rge. 23 E/W
Location as "NE/CNW $\frac{1}{4}$ SW $\frac{1}{4}$ " or footage from lines _____
2110' NSL & 330' WEL SE/4
Lease Owner Oil Interests Limited
Lease Name Wm. Nall Well No. 1
Office Address 1115 E. Waterman, Wichita, Ks. 67211
Character of Well (Completed as Oil, Gas or Dry Hole) _____
dry hole

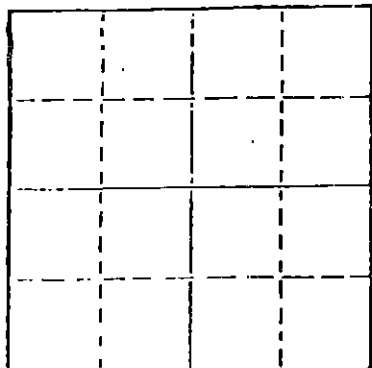

Locate well correctly on above
Section Plat

Date Well completed 10/19 19 80
Application for plugging filed 10/19 19 80
Application for plugging approved 10/19 19 80
Plugging commenced 10/19 19 80
Plugging completed 10/19 19 80
Reason for abandonment of well or producing formation _____
no commercial quantities of oil or gas encountered
If a producing well is abandoned, date of last production _____
-- 19

Was permission obtained from the Conservation Division or
its agents before plugging was commenced? _____

Name of Conservation Agent who supervised plugging of this well _____
Producing formation _____ Depth to top _____ Bottom _____ Total Depth of Well 4750
Show depth and thickness of all water, oil and gas formations.

OIL, GAS OR WATER RECORDS

CASING RECORD

FORMATION	CONTENT	FROM	TO	SIZE	PUT IN	PULLED OUT
surface hole	shale	surf	282	8-5/8	274	none

Describe in detail the manner in which the well was plugged, indicating where the mud fluid
was placed and the method or methods used in introducing it into the hold. If cement or other
plugs were used, state the character of same and depth placed, from _____ feet to
_____ feet for each plug set.

Fluid to 600', plug, 60 sx
Fluid to 280', plug, 30 sx
Fluid to 40', plug, 10 sx
Rat hole 5 sx

RECEIVED
STATE CORPORATION COMMISSION

OCT 28 1980

CONSERVATION DIVISION
Wichita, Kansas

(If additional description is necessary, use BACK of this sheet.)
Name of Plugging Contractor D N B DRILLING, INC.
515 R. H. Garvey Building
Wichita, Kansas 67202

STATE OF Kansas COUNTY OF Sedgwick, ss.
Ella Priess (employee of owner) or (owner or operator)
of the above-described well, being first duly sworn on oath, says: That I have knowledge of
the facts, statements, and matters herein contained and the log of the above-described well
as filed and that the same are true and correct. So help me God.

(Signature)

Ella Priess

515 R.H. Garvey Bldg., Wichita, Ks. 67202
(Address)

SUBSCRIBED AND SWORN TO before me this 20th day of October, 19 80

Dorothy L. Schmidt
Dorothy L. Schmidt Notary Public.

My commission expires April 30, 1983

DOROTHY L. SCHMIDT
STATE NOTARY PUBLIC
Sedgwick County, Kansas
My Appt. Exp. April 30, 1983

DRILLER'S LOG

OIL INTERESTS LIMITED
No. 1 Wm. Nail
2110' NSL&330' WEL SE/4
Sec. 1-245-23W
Hodgeman Co., Ks.

Commenced: 10-11-80
Completed: 10-19-80

Surface Casing: 274' of 8-5/8"
cemented w/180 sx common, 2% gel,
3% cc

FORMATION

DEPTH

Surface Hole	0 - 282
Shale & Sand	282 - 550
Shale, Red Bed & Sand	550 - 1460
Anhydrite	1460 - 1479
Shale	1479 - 1850
Shale & Sand	1850 - 2315
Lime & Shale	2315 - 4250
Lime	4250 - 4610
Lime & Shale	4610 - 4638
Lime	4638 - 4685
Lime & Shale	4685 - 4750 RTD

I do hereby certify that the foregoing statements are true and correct to the best of my knowledge and belief.

D N B DRILLING, INC.

Ella Priess

Ella Priess

STATE OF KANSAS: ss:

Subscribed and sworn to before me this 23rd day of October, 1980.

10-28-80

RECEIVED
STATE CORPORATION COMMISSION

OCT 28 1980

CONSERVATION DIVISION
Wichita, Kansas

Dorothy L. Schmidt
Dorothy L. Schmidt, Notary Public

DOROTHY L. SCHMIDT
STATE NOTARY PUBLIC
Sedgwick County, Kansas
My Appt. Exp. April 30, 1983