


Give All Information Completely
Make Required Affidavit
Mail or Deliver Report to:
Conservation Division
State Corporation Commission
211 No. Broadway
Wichita, Kansas

WELL PLUGGING RECORD

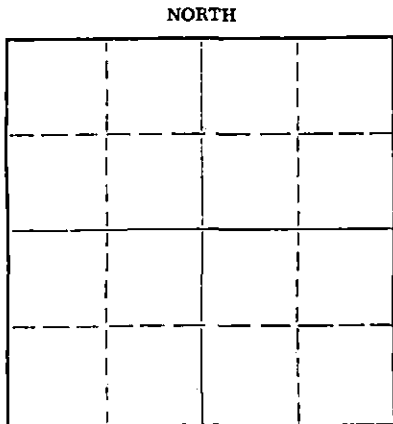

Locate well correctly on above Section Plat

Hodgeman County, Sec 1 Twp. 24S Rge. 23W (E) (W)
Location as "NE/CNW&SW&" or footage from lines G W SE
Lease Owner Wilcox Oil Company
Lease Name Nall Well No. 1
Office Address Box 252 Kingman, Kansas
Character of Well (completed as Oil, Gas or Dry Hole) Oil
Date well completed 19
Application for plugging filed 19
Application for plugging approved 19
Plugging commenced November 27, 1962 19
Plugging completed Decmeber 2, 1962 19
Reason for abandonment of well or producing formation Dry

If a producing well is abandoned, date of last production 19
Was permission obtained from the Conservation Division or its agents before plugging was commenced? Yes

Name of Conservation Agent who supervised plugging of this well Hugh Scott
Producing formation Depth to top Bottom Total Depth of Well 4670 Feet
Show depth and thickness of all water, oil and gas formations.

OIL, GAS OR WATER RECORDS

CASING RECORD

FORMATION	CONTENT	FROM	TO	SIZE	PUT IN	PULLED OUT
				8 5/8	278	none
				4 7/2	none	2518

Describe in detail the manner in which the well was plugged, indicating where the mud fluid was placed and the method or methods used in introducing it into the hole. If cement or other plugs were used, state the character of same and depth placed, from feet to feet for each plug set.

Cleaned out cellar and pushed plug to 4500', and 30' sand. Dumped 5 sx. cement. Worked and shot pipe @ 4100'.
Worked pipe and circulated mud and spotted 14 bbl. oil.
Worked pipe and shot @ 4000' and 3362'. Mud came in @ 2680'.
Worked pipe and shot @ 3100'. Mud came in to 1300'. Circulated out mud and shot @ 2970'. Mud came in @ 1214'. Circulated out mud and shot @ 2822'. Mud came in to 800'. Circulated out mud.
Worked pipe and shot @ 2502. Pulled pipe.
Plugged and bailed. Built rock bridge @ 275' and dumped 35 sx. cement. Filled hole and built rock bridge @ 50'. Capped well with 15 sx. cement.

RECEIVED
STATE CORPORATION COMMISSION

DEC 12 1962

CONSERVATION DIVISION
Wichita, Kansas

(If additional description is necessary, use BACK of this sheet)

Name of Plugging Contractor Forbes Casing Pulling, Inc.
Address Box 221 Great Bend, Kansas

STATE OF Kansas, COUNTY OF Barton, ss.
J. O. Forbes (employee of owner) or (owner or operator) of the above-described well, being first duly sworn on oath, says: That I have knowledge of the facts, statements, and matters herein contained and the log of the above-described well as filed and that the same are true and correct. So help me God.

(Signature) J. O. Forbes
Box 221 Great Bend, Kansas
(Address)

SUBSCRIBED AND SWORN TO before me this 5th day of December, 1962

My commission expires July 23, 1966
Carolyn Herren
Notary Public.

DRILLER'S LOG

Company	Jones-Gabert Oil Co.
Contractor:	Jones-Gabert Oil, Inc.
Farm:	# 1 Nall
	C SW SE, Sec. 1-24S-23W
	Hodgeman Co., Kansas
Commenced:	10/31/62
Completed:	11/14/62
Casing:	278' of 8-5/8"
	4740' of 4-1/2"

0	-	215	Surface
215	-	278	Red bed & shale
278	-	310	Cement & plug, red bed
310	-	930	Red bed & clay
930	-	1025	Dakota (sand)
1025	-	1245	Shale & shells
1245	-	1425	Shale red bed
1425	-	1465	Anhydrite
1465	-	1715	Shale
1715	-	2090	Shale & clay
2090	-	2330	Shale w/lime streaks
2330	-	2390	Lime - shale
2390	-	2545	Shale & lime
2545	-	2675	Lime & shale
2675	-	2755	Lime & Shale
2755	-	2870	Lime w/shale streaks
2870	-	2960	Lime & shale
2960	-	3100	Lime & shale
3100	-	3250	Lime & shale
3250	-	3365	Shale & lime streaks
3365	-	3515	Lime & shale
3515	-	3659	Lime, shale, chalk
3659	-	3778	Shale & chalk with lime streaks
3778	-	3816	Shale & lime
3816	-	3887	Lime w/shale brks.
3887	-	3950	Shale & lime
3950	-	4031	Lime w/shale streaks
4031	-	4071	Lime (Lans.K.C.)
4071	-	4128	Lime
4128	-	4174	Lime
4174	-	4200	Shale, chalk & lime
4200	-	4275	Lime w/shale streaks
4275	-	4319	Lime
4319	-	4370	Lime
4370	-	4416	Lime & shale, some chert streaks
4416	-	4452	Lime w/shale streaks
4452	-	4508	Lime
4508	-	4560	Lime & shale
4560	-	4572	Lime
4572	-	4583	Mississippi
4583	-	4595	Mississippi
4595	-	4605	Mississippi
4605	-	4644	Mississippi
4644	-	4702	Mississippi
4702	-	4739	Lime & chert
4739	-	4740	Lime & chert
4740	-		T. D.

RECEIVED
STATE CORPORATION COMMISSION

NOV 27 1962

CONSERVATION DIVISION
Wichita, Kansas

I, George R. Jones, do hereby certify that the above and foregoing is a true and correct copy of the log of the #1 Nall, C SW SE, Sec. 1-24S-23W, Hodgeman County, Kansas, as reflected by the files of Jones-Gebert Oil, Inc.

George R. Jones
George R. Jones

State of Kansas)
) ss.
County of Sedgwick)

Subscribed and sworn to before me, a Notary Public, in and for Sedgwick County, Kansas, this 20th day of November, 1962.

Barbara J. Layton
Barbara J. Layton, Notary Public

My Commission Expires:
February 1, 1964

RECEIVED
STATE CONSERVATION COMMISSION
NOV 27 1962
CONSERVATION DIVISION
Wichita, Kansas