


WELL PLUGGING RECORD

Give All Information Completely
Make Required Affidavit
Mail or Deliver Report to:
Conservation Division
State Corporation Commission
211 No. Broadway
Wichita, Kansas

NORTH

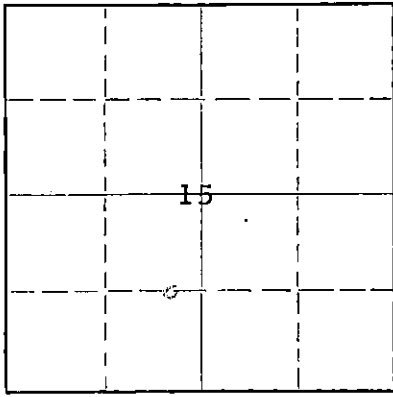

Locate well correctly on above Section Plat

Gray County, Sec. 15 Twp. 26 Rge. (E) 30(W)
Location as "NE/CNW/SW" or footage from lines 1320 Ft #/L 2860 Ft E/L
Lease Owner Edwin G. Bradley et al
Lease Name Laird Well No. 1
Office Address 826 Union Center Bldg., Wichita, Kans
Character of Well (completed as Oil, Gas or Dry Hole) dry hole
Date well completed Nov 11 1958
Application for plugging filed Nov 14 1958
Application for plugging approved Nov 17 1958
Plugging commenced Nov 19 1958
Plugging completed Nov 22 1958
Reason for abandonment of well or producing formation dry hole

If a producing well is abandoned, date of last production none 19
Was permission obtained from the Conservation Division or its agents before plugging was commenced? yes

Name of Conservation Agent who supervised plugging of this well Merle Rives
Producing formation none Depth to top Bottom Total Depth of Well 5114 Feet
Show depth and thickness of all water, oil and gas formations.

OIL, GAS OR WATER RECORDS

CASING RECORD

FORMATION	CONTENT	FROM	TO	SIZE	PUT IN	PULLED OUT
Mississippian	water	5085	5088	13"	520'	none
Mississippian	water	5062	5068	5 1/2"	5114'	962'

Describe in detail the manner in which the well was plugged, indicating where the mud fluid was placed and the method or methods used in introducing it into the hole. If cement or other plugs were used, state the character of same and depth placed, from feet to feet for each plug set.

Filled up 5 1/2" casing with sand to 5045'
dumped 5 sacks cement
shot off pipe at 4020'
circulated hole with 90 sacks mud
shot off pipe at 2170
shot off pipe at 1326
shot off pipe at 1160'
shot off pipe at 9621
pulled 962' 5 1/2" pipe
set 10' rock bridge fro. 490-500
dumped 30 sacks cement
filled with mud to 20' from top
Set 5' rock bridge from 15' to 20'
Ten sacks cement to base of cellar

(If additional description is necessary, use BACK of this sheet)

Name of Plugging Contractor West Supply Company, Inc.
Address Chase, Kansas

STATE OF KANSAS, COUNTY OF SEDGWICK, ss.
Geo. R. Shaw (employee of owner) or (owner/operator) of the above-described well, being first duly sworn on oath, says: That I have knowledge of the facts, statements, and matters herein contained and the log of the above-described well as filed and that the same are true and correct. So help me God.

(Signature) Edwin G. Bradley, 826 Union Center
by Geo R Shaw (Address)

SUBSCRIBED AND SWORN TO before me this 24th day of November

My commission expires July 30, 1962

RECEIVED
STATE CORPORATION COMMISSION
NOV 25 1962
Notary Public.

PLUGGING
FILE SEC..... T..... R.....
BOOK PAGE..... LINE.....

CONSERVATION DIVISION
Wichita, Kansas
11-25-58