


STATE OF KANSAS
STATE CORPORATION COMMISSION

Give All Information Completely
Make Required Affidavit
Mail or Deliver Report to:
Conservation Division
State Corporation Commission
212 North Market, Insurance Bldg.
Wichita, Kansas

RP

15-693-10018-0000

WELL PLUGGING RECORD

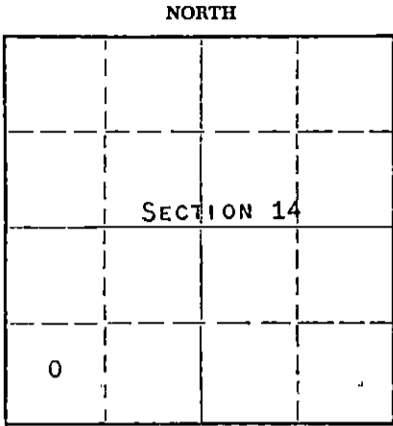

Locate well correctly on above
Section Plat

KEARNY County. Sec. 14 Twp. 26S Rge. 35W (#) (W)
Location as "NE/CNW/SW" or footage from lines. C SW SW
Lease Owner PETROLEUM, INC.
Lease Name FEDERAL "B" Well No. 1
Office Address ROUTE 2, GREAT BEND, KANSAS
Character of Well (completed as Oil, Gas or Dry Hole) DRY HOLE
Date well completed APRIL 25 1960
Application for plugging filed APRIL 25 1960
Application for plugging approved APRIL 25 1960
Plugging commenced APRIL 25 1960
Plugging completed APRIL 26 1960
Reason for abandonment of well or producing formation NO PRODUCIBLE ZONES

If a producing well is abandoned, date of last production NONE 19
Was permission obtained from the Conservation Division or its agents before plugging was commenced? YES

Name of Conservation Agent who supervised plugging of this well W. L. LACKAMP
Producing formation ----- Depth to top ----- Bottom ----- Total Depth of Well 5278 Feet
Show depth and thickness of all water, oil and gas formations.

OIL, GAS OR WATER RECORDS

CASING RECORD

FORMATION	CONTENT	FROM	TO	SIZE	PUT IN	PULLED OUT
				8-5/8"	780'	NONE

Describe in detail the manner in which the well was plugged, indicating where the mud fluid was placed and the method or methods used in introducing it into the hole. If cement or other plugs were used, state the character of same and depth placed, from _____ feet to _____ feet for each plug set.

MUDDED UP WITH HEAVY MUD TO 4200' FOLLOWED BY WOODEN PLUG. PLACED 30 SACKS CEMENT ON TO PLUG THROUGH DRILL PIPE. MUDDED UP WITH HEAVY MUD TO 2650' FOLLOWED BY WOODEN PLUG. PLACED 100 SACKS CEMENT ON TO PLUG THROUGH DRILL PIPE. MUDDED UP WITH HEAVY MUD TO 600' FOLLOWED BY WOODEN PLUG AND 20 SACKS CEMENT. MUDDED UP WITH HEAVY MUD TO 35' FOLLOWED BY WOODEN PLUG AND 1/4 SACK HULLS. PLACED 10 SACKS CEMENT ON TO PLUG THROUGH 4 1/2" CASING. SET 4 1/2" CASING 4 1/2' ABOVE GROUND LEVEL WITH FULL LEGAL IDENTIFICATION.

RECEIVED
STATE CORPORATION COMMISSION

MAY 9 1960

CONSERVATION DIVISION
Wichita, Kansas

(If additional description is necessary, use BACK of this sheet)

Name of Plugging Contractor GARVEY DRILLING COMPANY
Address ROUTE 2, GREAT BEND, KANSAS

STATE OF KANSAS, COUNTY OF BARTON, ss.
DON SEARLE (employee of owner) or (owner) of the above-described well, being first duly sworn on oath, says: That I have knowledge of the facts, statements, and matters herein contained and the log of the above-described well as filed and that the same are true and correct. So help me God.

(Signature) *Don Searle*
ROUTE 2, GREAT BEND, KANSAS
(Address)

SUBSCRIBED AND SWORN TO before me this 4TH day of MAY, 1960

My commission expires APRIL 14, 1963

Archer J. Miles
Notary Public.



WELL LOG

15-093-16618-0000

COMPANY PETROLEUM, INCORPORATED

SEC. 14 T. 26S R. 35W

FARM FEDERAL "B" NO. 1

LOC. C-SW, SW


TOTAL DEPTH 5278'

COUNTY KEARNEY CO., KANSAS

COMM. April 8, 1960

COMP. April 26, 1960

CONTRACTOR GARVEY DRILLING COMPANY

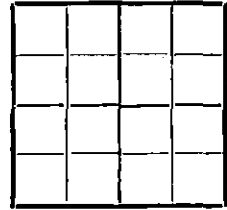

CASING 8 5/8" @ 780' w/500 sax.

ELEVATION 3000' DF

PRODUCTION D & A

FIGURES INDICATE BOTTOM OF FORMATIONS

280	Surface soil & sand
600	Sand & shale
780	Shale & shells
880	Lime w/shale streaks
1390	Shale & red bed
1605	Sand
1640	Shale & red bed
2060	Red bed & gyp
2290	Shale & shells
3155	Lime & shale
3245	Sandy lime & shale
3490	Lime & shale
3800	Chalky lime & shale
4965	Lime & shale
5015	Shale, lime & sand
5055	Shale & sand
5278	Lime & shale
5278	T. D.

RECEIVED
STATE CORPORATION COMMISSION

MAY 9 1960

CONSERVATION DIVISION
Wichita, Kansas

State of KANSAS
County of BARTON } ss:

I, VERNE A. MORRIS of GARVEY DRILLING COMPANY

upon oath state that the above and foregoing is a true and correct copy of the log of the #1 FEDERAL "B" well.

Verne A. Morris

Subscribed and sworn to before me this 3rd day of May 1960

My Commission Expires: April 14, 1963

Arthur J. Miles
NOTARY PUBLIC