


Give All Information Completely  
Make Required Affidavit  
Mail or Deliver Report to:  
Conservation Division  
State Corporation Commission  
800 Bitting Building  
Wichita, Kansas

*R*  
**WELL PLUGGING RECORD**

15-093-10006-0000

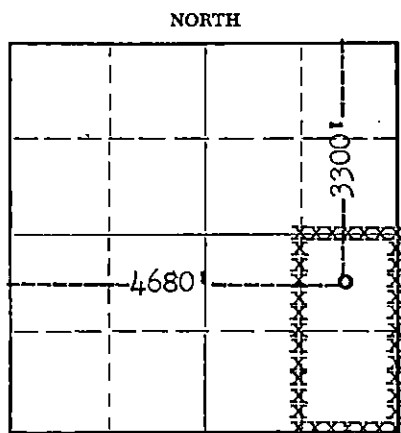

Locate well correctly on above Section Plat

Kearny County. Sec. 12 Twp. 26S Rge.      (E) 35W (W)  
Location as "NE/CNW/SE" or footage from lines C NE SE  
Lease Owner Helmerich & Payne, Inc.  
Lease Name USA "D" Well No. 5  
Office Address P. O. Box 255, Garden City, Kansas  
Character of Well (completed as Oil, Gas or Dry Hole) Dry Hole  
Date well completed      19       
Application for plugging filed August 5, 19 60  
Application for plugging approved August 9, 19 60  
Plugging commenced August 25, 19 60  
Plugging completed August 27, 19 60  
Reason for abandonment of well or producing formation non-commercial

If a producing well is abandoned, date of last production      19       
Was permission obtained from the Conservation Division or its agents before plugging was commenced? Yes

Name of Conservation Agent who supervised plugging of this well Mr. Frank Broadfoot  
Producing formation      Depth to top      Bottom      Total Depth of Well 5194 Feet  
Show depth and thickness of all water, oil and gas formations.

**OIL, GAS OR WATER RECORDS**

**CASING RECORD**

FORMATION	CONTENT	FROM	TO	SIZE	PUT IN	PULLED OUT
		Surface	840	8-5/8"	840	0
		Surface	5192	2-7/8"	5192	2505

Describe in detail the manner in which the well was plugged, indicating where the mud fluid was placed and the method or methods used in introducing it into the hole. If cement or other plugs were used, state the character of same and depth placed, from      feet to      feet for each plug set.

Shot 2-7/8" EUE Tubing off at 2505'.  
Spotted 75 sacks Pozmix from 2450 to 2200'.  
Heavy mud from 2200' to 800'.  
Spotted 20 sacks Pozmix from 800' to 730'.  
Heavy mud from 730' to 40'.  
Rock Bridge from 40' to 30'.  
Capped well with 10 sacks cement. 4 1/2" x 12' length of pipe embedded in surface cement with 4' extending above the general ground level. Entire length of pipe filled with cement.  
Cleaned up surface location.

**RECEIVED**  
STATE CORPORATION COMMISSION

SEP 9 1960

CONSERVATION DIVISION  
Wichita, Kansas

(If additional description is necessary, use BACK of this sheet)  
Name of Plugging Contractor J. O. Forbes d/b/a Forbes Casing Pulling Company  
Address P. O. Box 221, Great Bend, Kansas

STATE OF Kansas, COUNTY OF Finney, ss.  
T. E. Mort (employee of owner) or (~~owner or operator~~) of the above-described well, being first duly sworn on oath, says: That I have knowledge of the facts, statements, and matters herein contained and the log of the above-described well as filed and that the same are true and correct. So help me God.

(Signature) T. E. Mort  
P. O. Box 255, Garden City, Kansas  
(Address)

SUBSCRIBED AND SWORN TO before me this 8th day of September, 19 60

My commission expires July 1, 1964

Robert M. Boyd  
Notary Public.

USA "D" No. 5  
 Helmerich & Payne, Inc.  
 C NE SE Section 12-26S-34W  
 Kearny County, Kansas

15-093-10006-0000

**CASING RECORD:**

26 Jts. 8-5/8" @ 840' w/350 sxs. Pozmix;2% CC &  
 100 sxs. Reg.;2% CC  
 166 Jts. 2-7/8" Tbg. Set @ 5192' & cmtd. w/770 sxs  
 Common w/855 cubic ft. of Diacel followed w/405 sxs.  
 Pozmix.

COMMENCED: 12-29-59  
 COMPLETED: 1-16-60

	<u>FROM</u>	<u>TO</u>
Surface	0	250
Sand & Shale	250	795
Red Bed & Sand	795	855
Shale & Clay	855	1290
Red Bed, Shale & Sand	1290	1929
Sand & Shale	1929	1990
Shale & Sand	1990	2250
Shale & Clay	2250	2469
Shale & Sand	2469	2612
Shale & Lime	2612	2726
Lime & Shale	2726	3283
Shale & Lime	3283	3435
Lime & Shale	3435	3679
Shale & Lime	3679	3995
Lime	3995	4054
Shale & Lime	4054	4163
Lime & Shale	4163	4700
Lime	4700	4776
Lime & Shale	4776	4869
Lime	4869	4885
Lime & Shale	4885	4920
Lime & Sand	4920	5001
Lime	5001	5194

**TOTAL DEPTH** **5194**

STATE OF OKLAHOMA )  
 ) SS  
 County of Tulsa )

I hereby affirm that the above and foregoing is a true and correct copy of the log of the USA "D" No. 5 well, located in Section 12-26S-34W, Kearny County, Kansas.

HELMERICH & PAYNE, INC.

*Harry Payne*  
 Vice President

Subscribed and sworn to before me a Notary Public this 28th day of January, 1960.

*Dagmar Waldrup*  
 Notary Public

My commission expires:

8-15-61

9-15-60  
 RECEIVED  
 STATE OF OKLAHOMA  
 SEP 15 1960  
 CONSERVATION DIVISION  
 Wichita, Kansas