


15-155-60006-0008c

STATE OF KANSAS  
STATE CORPORATION COMMISSION

WELL PLUGGING RECORD

Give All Information Completely  
Make Required Affidavit  
Mail or Deliver Report to:  
Conservation Division  
State Corporation Commission  
212 North Market, Insurance Bldg.  
Wichita, Kansas

Reno County. Sec. 17 Twp. 22S Rge. (E) 7W (W)  
Location as "NE/CNW/SW" or footage from lines C SW/4 SE/4  
Lease Owner Skelly Oil Company  
Lease Name W. A. Gossage Well No. 1  
Office Address P.O. Box 649, McCook, Nebraska  
Character of Well (completed as Oil, Gas or Dry Hole) Dry Hole  
Date well completed August 4, 19 63  
Application for plugging filed August 5, 19 63  
Application for plugging approved August 8, 19 63  
Plugging commenced August 5, 19 63  
Plugging completed August 5, 19 63  
Reason for abandonment of well or producing formation Dry Hole

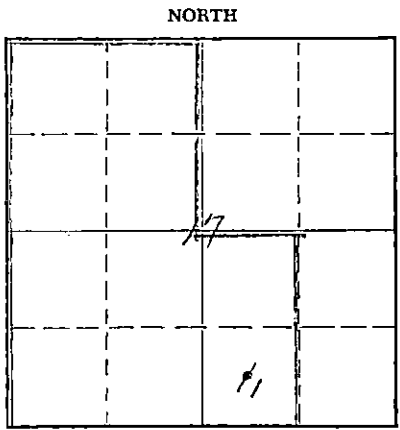

Locate well correctly on above Section Plat

If a producing well is abandoned, date of last production 19  
Was permission obtained from the Conservation Division or its agents before plugging was commenced? Yes (verbally)

Name of Conservation Agent who supervised plugging of this well Mr. Gilbert Toman  
Producing formation None Depth to top Bottom Total Depth of Well 3950 Feet  
Show depth and thickness of all water, oil and gas formations.

OIL, GAS OR WATER RECORDS

CASING RECORD

FORMATION	CONTENT	FROM	TO	SIZE OD	PUT IN	PULLED OUT
Arbuckle Lime	Dry	3810'	3950'	8-5/8"	355'	None

Describe in detail the manner in which the well was plugged, indicating where the mud fluid was placed and the method or methods used in introducing it into the hole. If cement or other plugs were used, state the character of same and depth placed, from feet to feet for each plug set.

50 sacks of cement	3950' to 3800'
Mud	3800' to 350'
1/4 sack hulls and wood plug	350' to 348'
20 sacks of cement	348' to 290'
Mud	290' to 40'
1/4 sack hulls and wood plug	40' to 38'
10 sacks cement	38' to 6'
Surface soil	6' to Surf.

RECEIVED  
STATE CORPORATION COMMISSION

AUG 26 1963  
8-26-63

CONSERVATION DIVISION  
Wichita, Kansas

(If additional description is necessary, use BACK of this sheet)  
Name of Plugging Contractor Garvey Drilling Company  
Address 352 No. Broadway, Wichita 2, Kansas

STATE OF Nebraska, COUNTY OF Red Willow, ss.  
C. F. Bass (employee of owner) of the above-described well, being first duly sworn on oath, says: That I have knowledge of the facts, statements, and matters herein contained and the log of the above-described well as filed and that the same are true and correct. So help me God.

(Signature) C. F. Bass  
P.O. Box 649, McCook, Nebraska (Address)

SUBSCRIBED AND SWORN TO before me this 22nd day of August, 19 63  
C. C. Lindsey Notary Public.

COMMISSION EXPIRES JUNE 13, 1969

My commission expires

# WELL LOG

15-155-60006-0000

COMPANY Skelly Oil Company

SEC. 17 T. 22S R. 7W

FARM Gossage NO. 1


LOC. C SW SE

TOTAL DEPTH 3950'

COUNTY Reno

COMM. 7-23-63 COMP. 8-5-63

CONTRACTOR Garvey Drilling Company

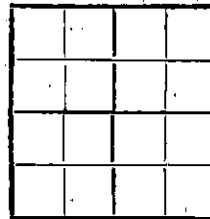

CASING 8 5/8" @ 363' w/300 sx

ELEVATION 1600' DF

PRODUCTION D & A

FIGURES INDICATE BOTTOM OF FORMATIONS

- 155' Sand and Gravel
- 290' Red Bed and Shale
- 908' Red Bed
- 1000' Red Bed, Shale and Shells
- 1185' Shale, Shells and Sand
- 1300' Shale and Lime
- 1740' Lime
- 1775' Lime and Shale
- 2350' Shale and Lime Streaks
- 2525' Shale
- 2540' Shale and Lime
- 2750' Lime
- 2785' Lime and Shale
- 2920' Shale
- 2943' Lime and Shale
- 3320' Lime
- 3405' Lime and Shale
- 3450' Lime
- 3505' Mississippi Chert
- 3578' Kinderhook Shale
- 3590' Kinderhook Lime
- 3685' Shale and Lime
- 3747' Shale w/Lime Streaks
- 3780' Cherty Viola and Sandy Lime
- 3796' Sand
- 3940' Lime and Shale
- 3950' Lime
- 3950' RTD

RECEIVED  
STATE CORPORATION COMMISSION

AUG 26 1963  
8-26-63  
CONSERVATION DIVISION  
Wichita, Kansas

State of Kansas } ss

County of Barton }

I, Sam N. Stephens of Garvey Drilling Company

upon oath state the above and foregoing is a true and correct copy of the log of the Gossage #1 well.

Sam N. Stephens

Subscribed and sworn to before me this 7th day of August 19 63

My Commission Expires: April 14th, 1967

Archer J. Wiles  
NOTARY PUBLIC